


*

20 531 P.I.C.A. 1 400 20 531 S.Q.F.T.

SUITE

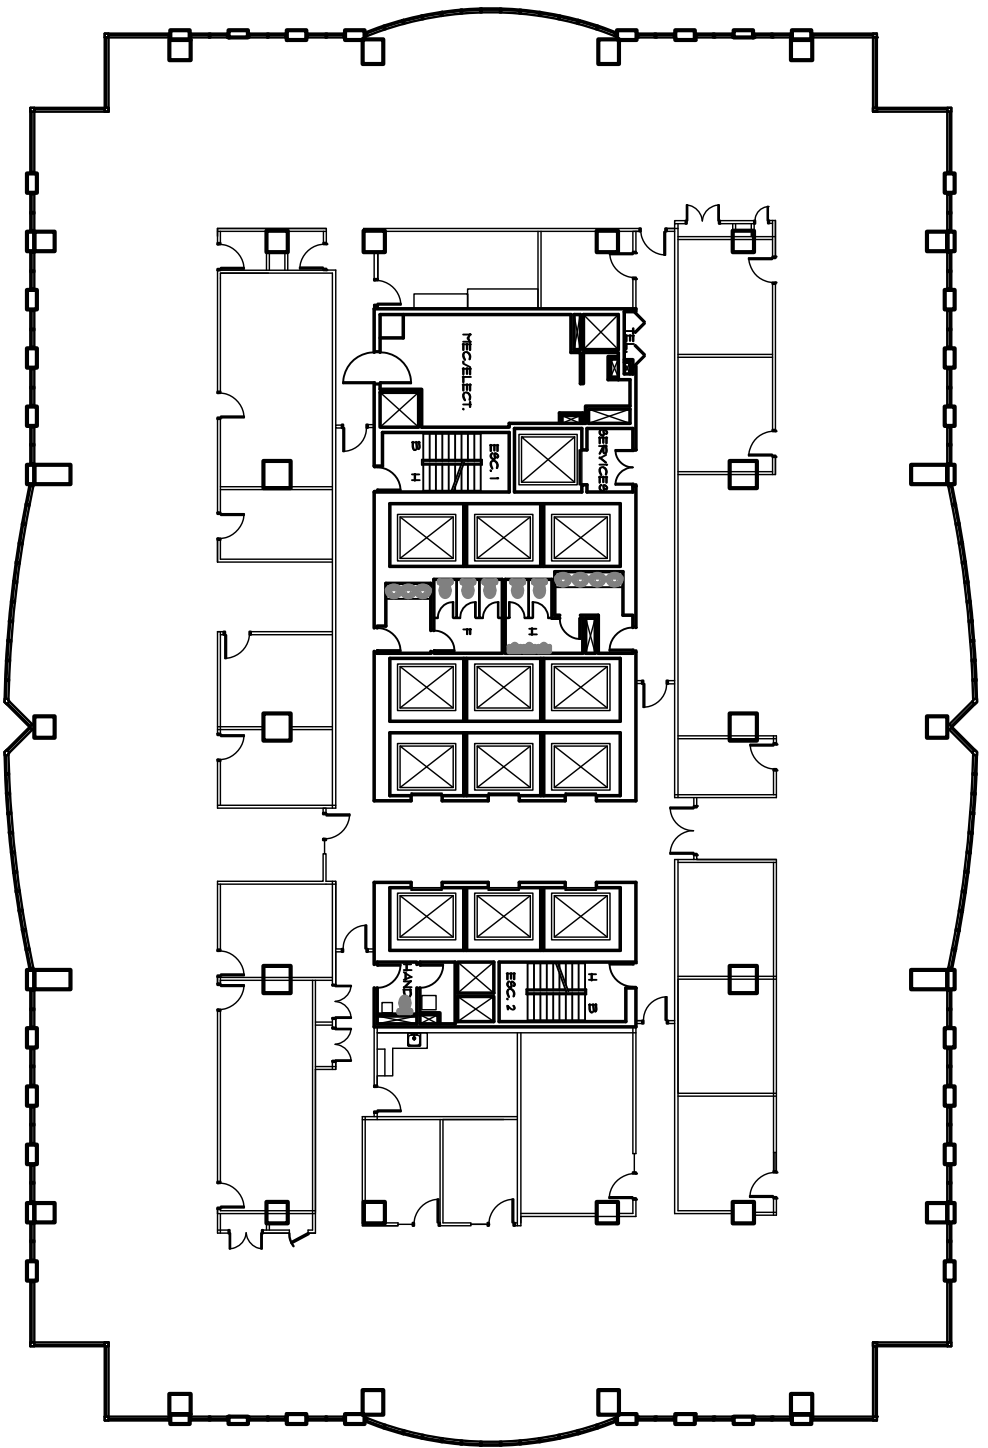

TEL QU'EXISTANT / AS BUILT

1 800 MCGILL COLLEGE
PLACE MONTREAL TRUST

REDBOURNE