

*
MANSFIELD


STE-CATHERINE

5906 P.I.C.A

3000

5906 SQ. FT.

SUITE

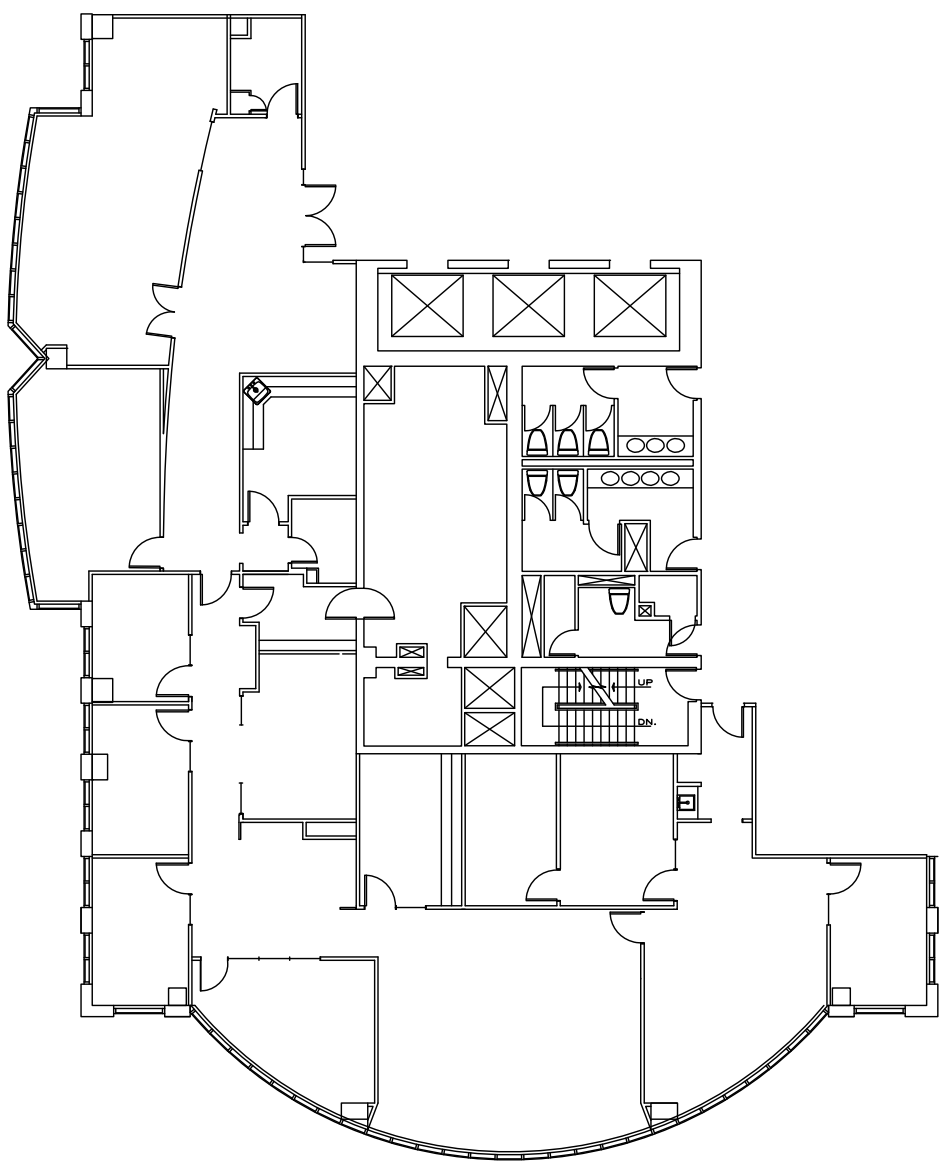

MCGILL COLLEGE

DE MAISONNEUVE

AS BUILT / TEL QUEL

1800 MCGILL COLLEGE
PLACE MONTREAL TRUST

REDBOURNE