

MANSFIELD


STE-CATHERINE

5970 P.I.CA.

SUITE

3010

5970 SQ.FT.

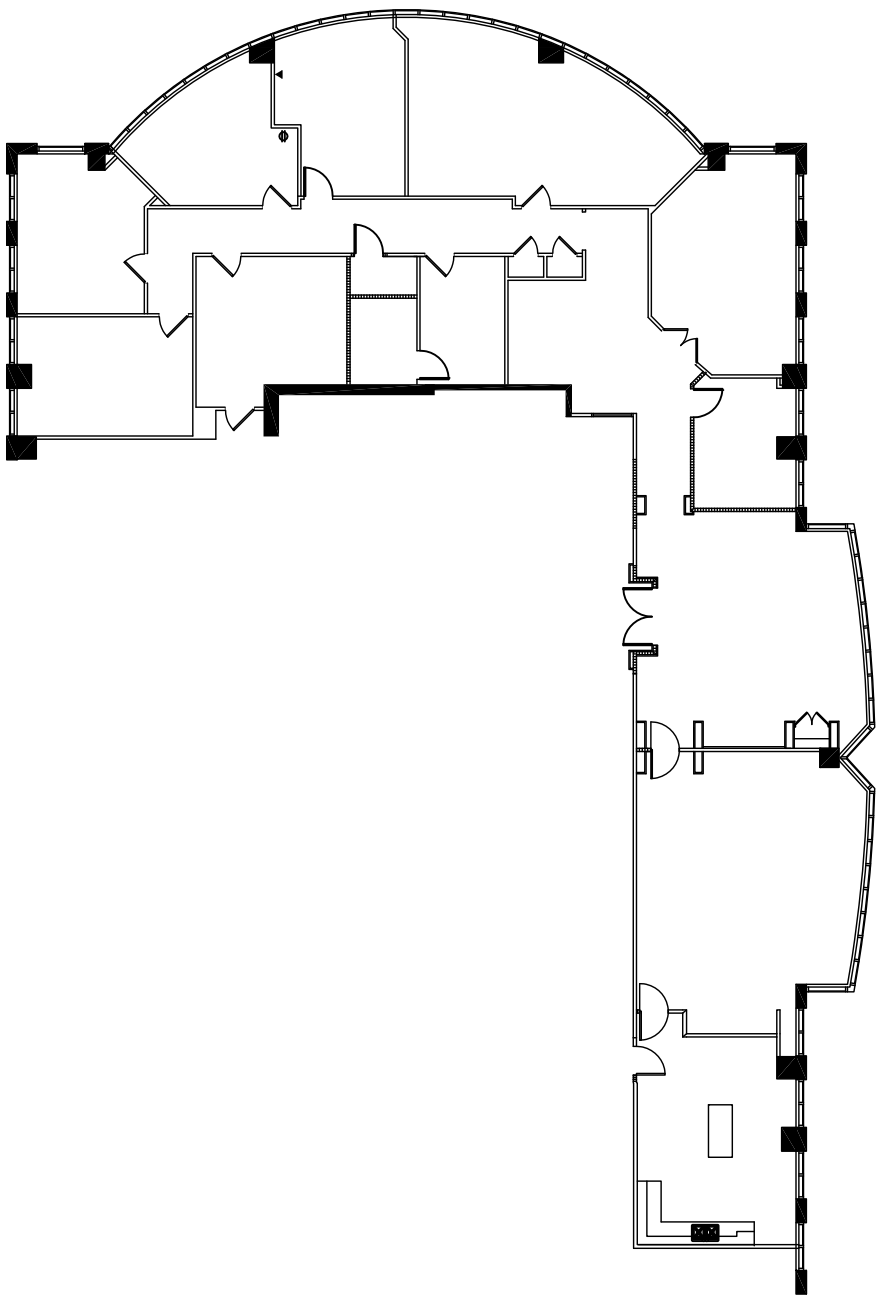

MCGILL COLLEGE

DE MAISONNEUVE

PLAN TEL QU'EXISTANT / AS BUILT PLAN

1800 MCGILL COLLEGE
PLACE MONTREAL TRUST

REDBOURNE