


1038 pl. G. SUITE 260 1038 sq. ft.

SUITE

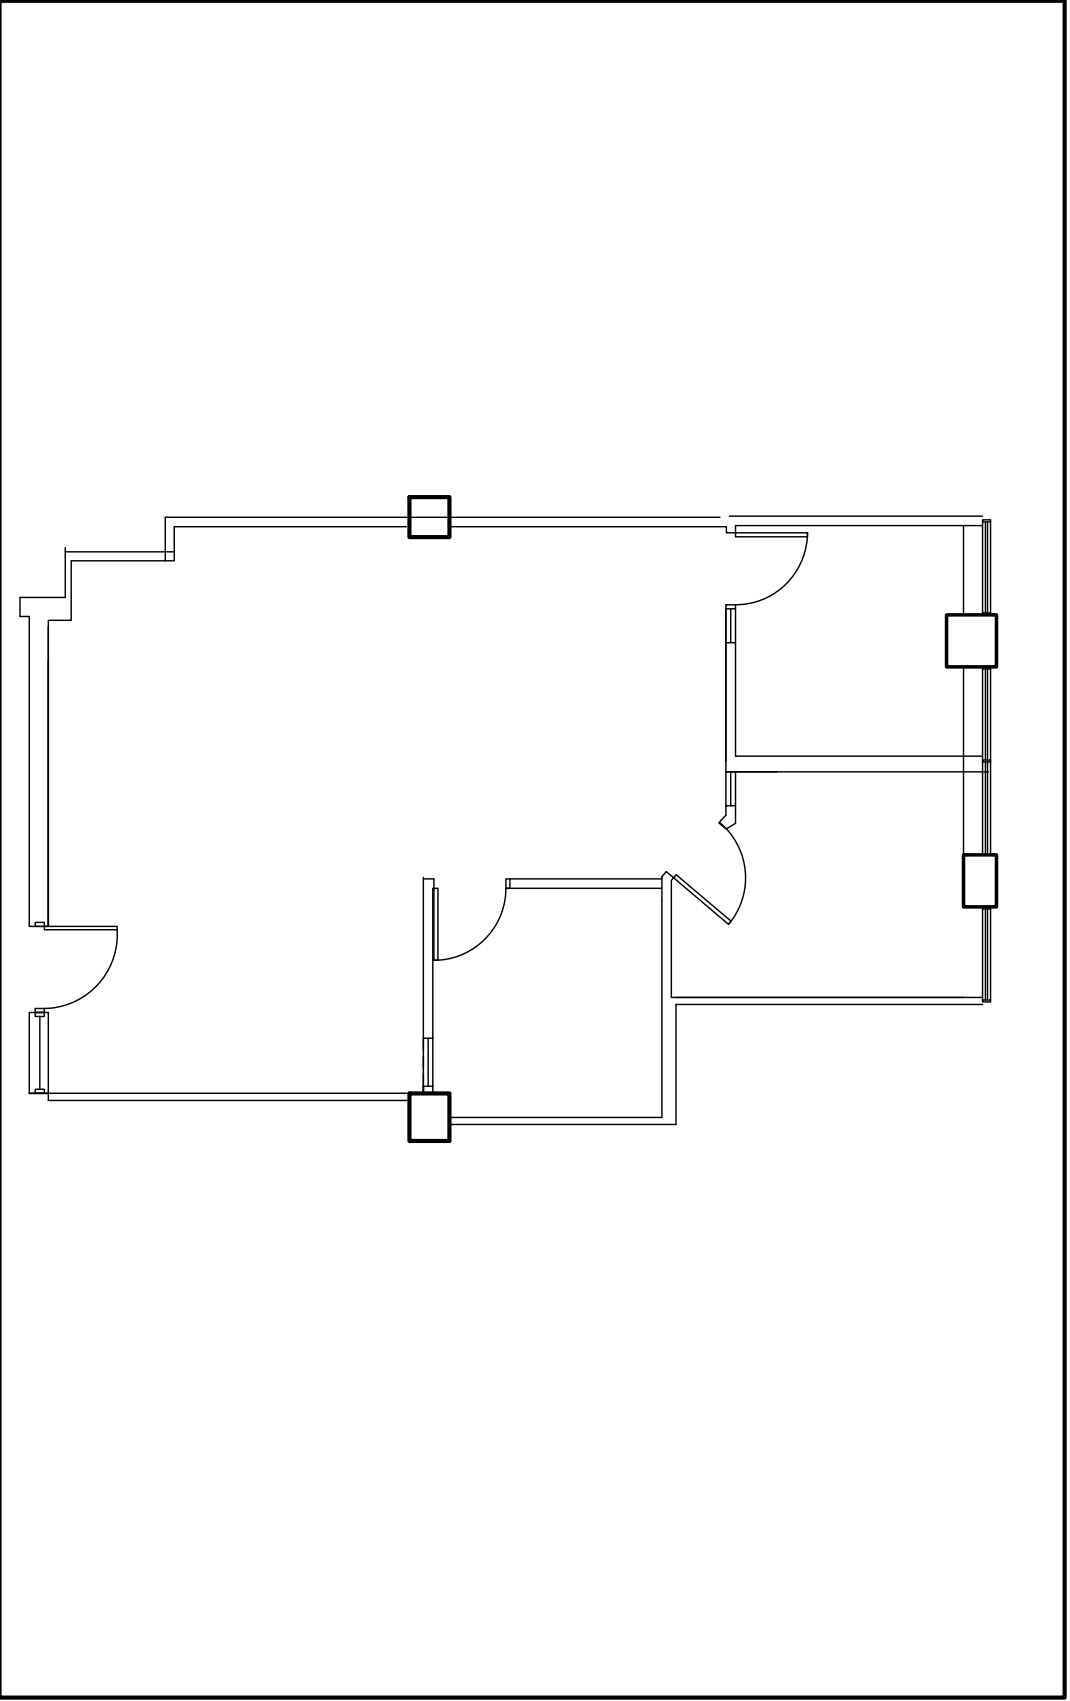

TEL QU'EXISTANT / AS BUILT PLAN

3100 COTE VERTU  
VILLE ST. LAURENT

REDBOURNE