


*

810 pl. ca.

SUITE

210

810 sq. ft.

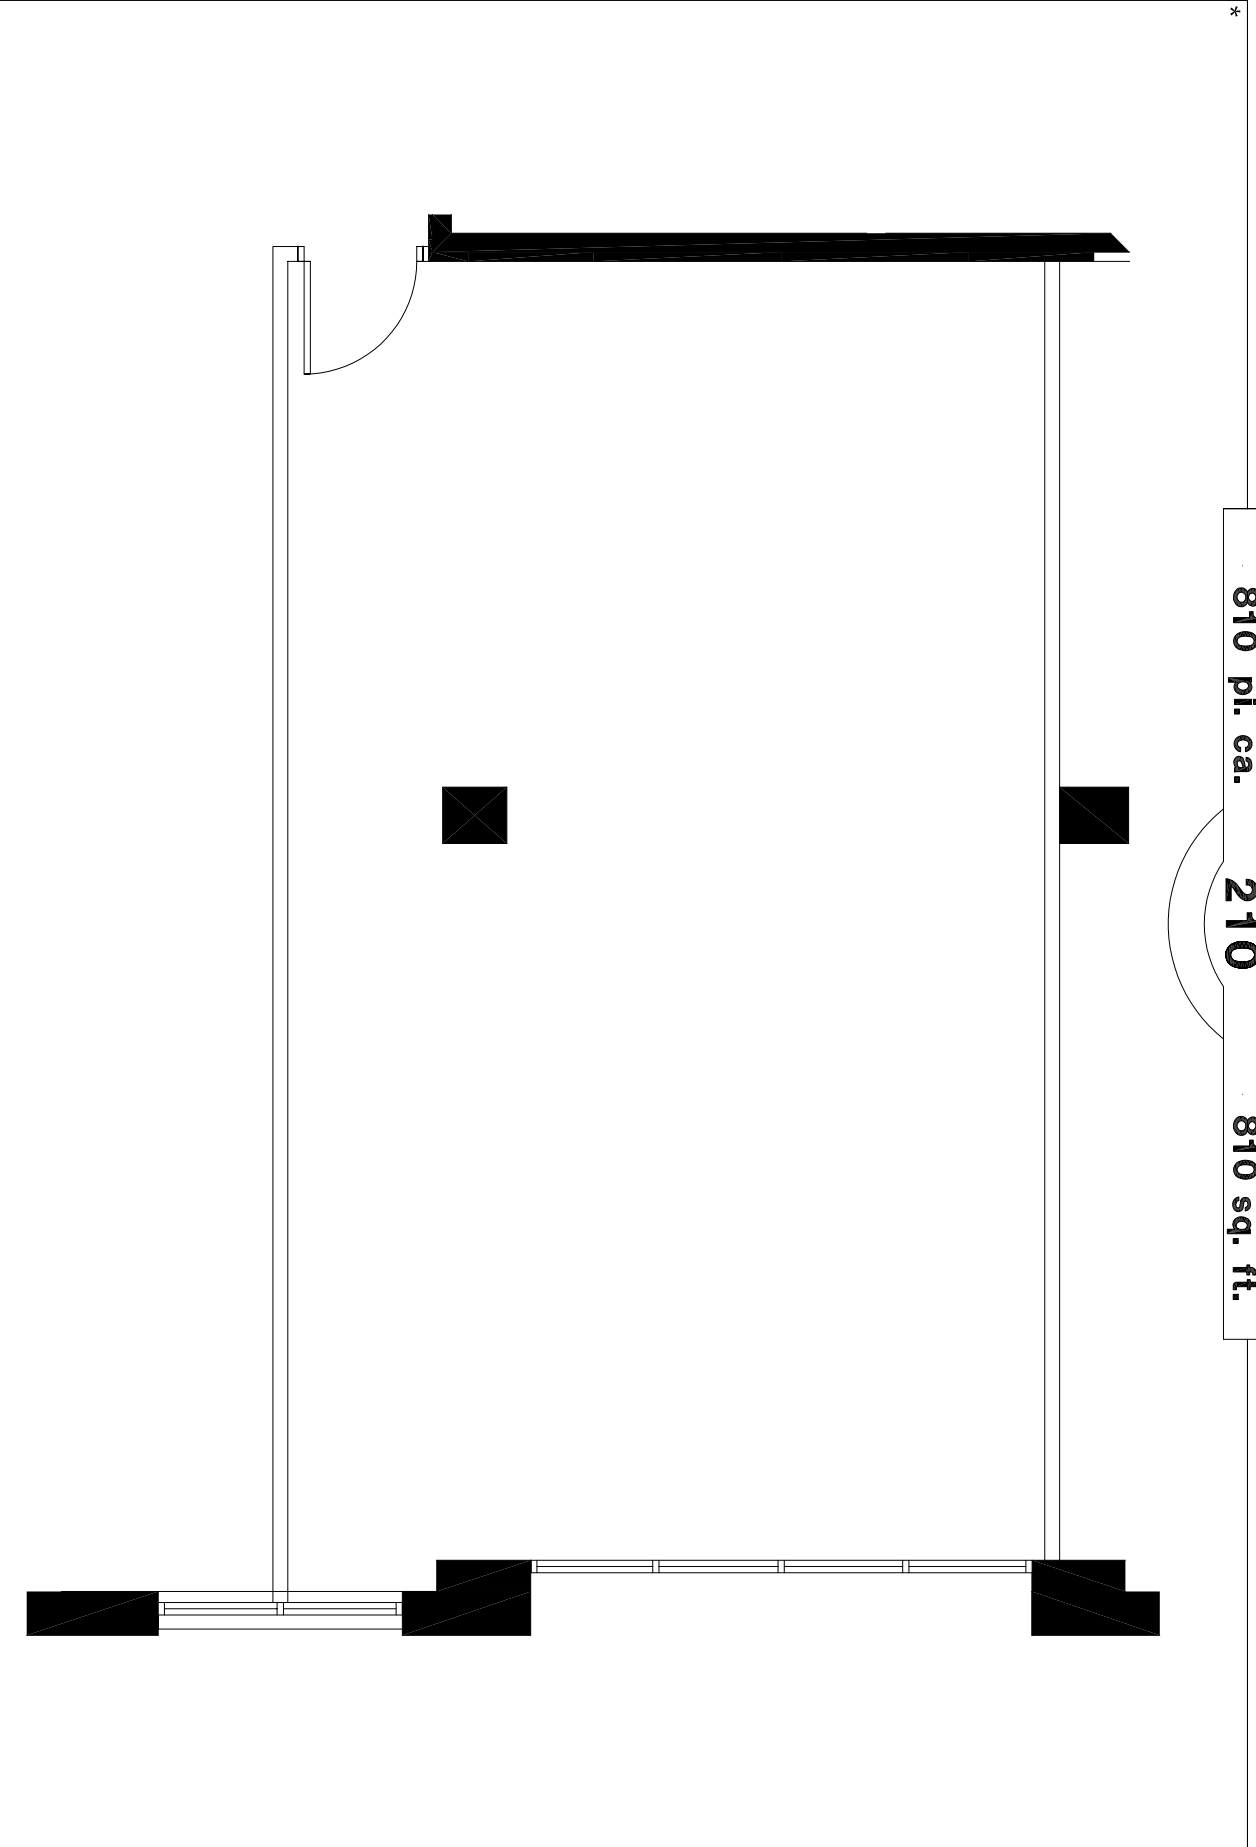

TEL QU'EXISTANT / AS BUILT PLAN

3773 COTE VERTU
VILLE ST. LAURENT

REDBOURNE