


3 575,73 PI. CA. 4IEME 3 575,73 SQ. FT.



TEL QUE CONSTRUIT / AS BUILT

3773 BOUL. GOTE-VERTU
4IEME ÉTAGE

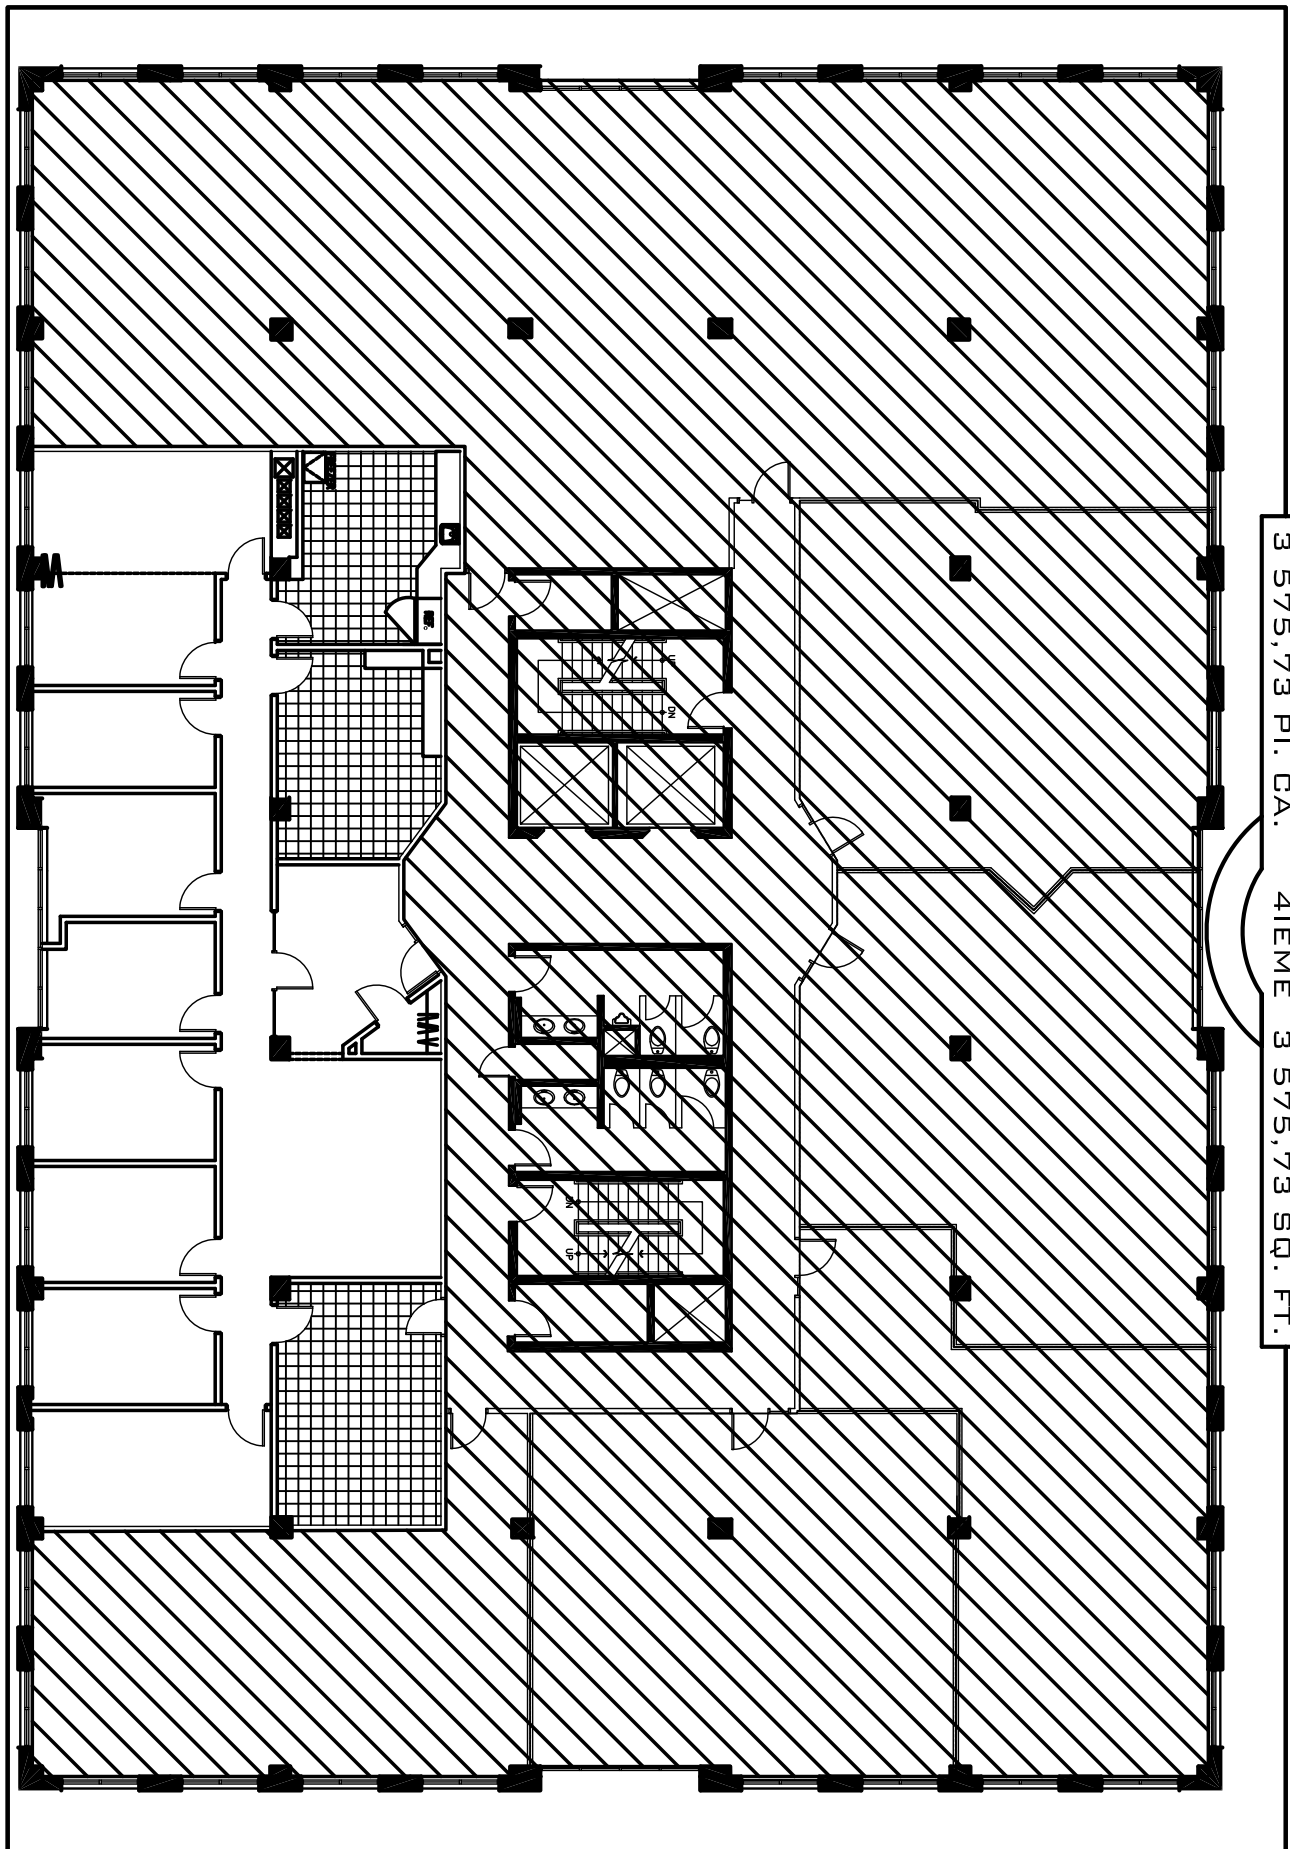