


+3162PI.GA. 260/208 +3162sq.ft.

SUITE

BOUL. COTE-VERTU

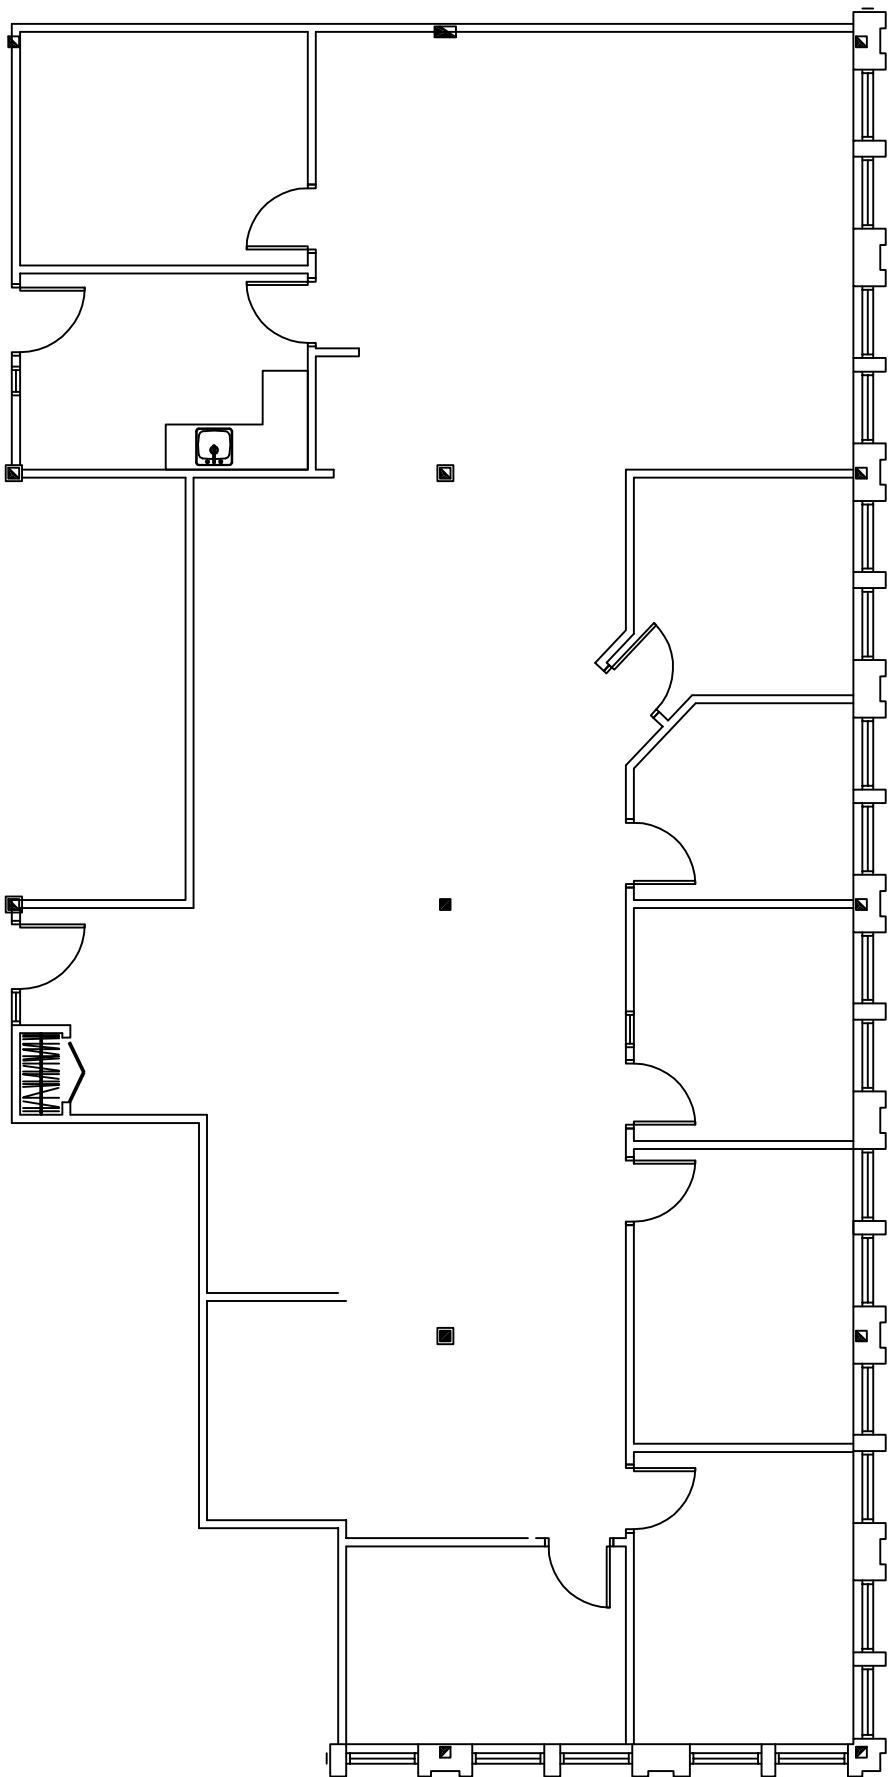

PLAN TEL QU'EXISTANT/ AS BUILT PLAN

3900 COTE VERTU  
VILLE ST. LAURENT

REDBOURNE