


2 894 PI.CA

SUITE  
202

2 894 SQ FT

BOUL. COTE-VERTU

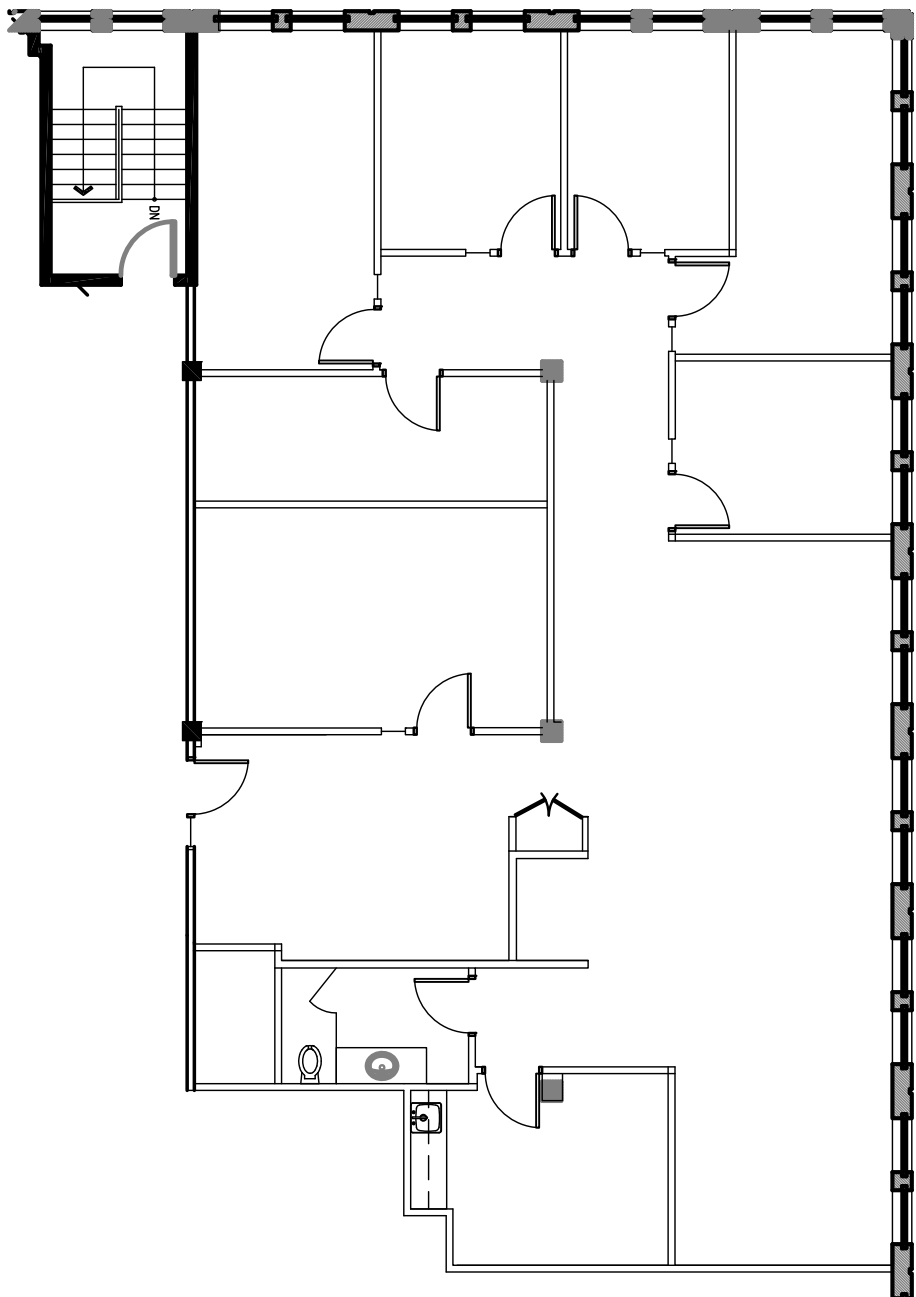

PLAN TEL QU'EXISTANT/ AS BUILT PLAN

3 900 COTE VERTU  
VILLE ST. LAURENT

REDBOURNE