


8,245 pl.

SUITE  
**210**

8,245 q.

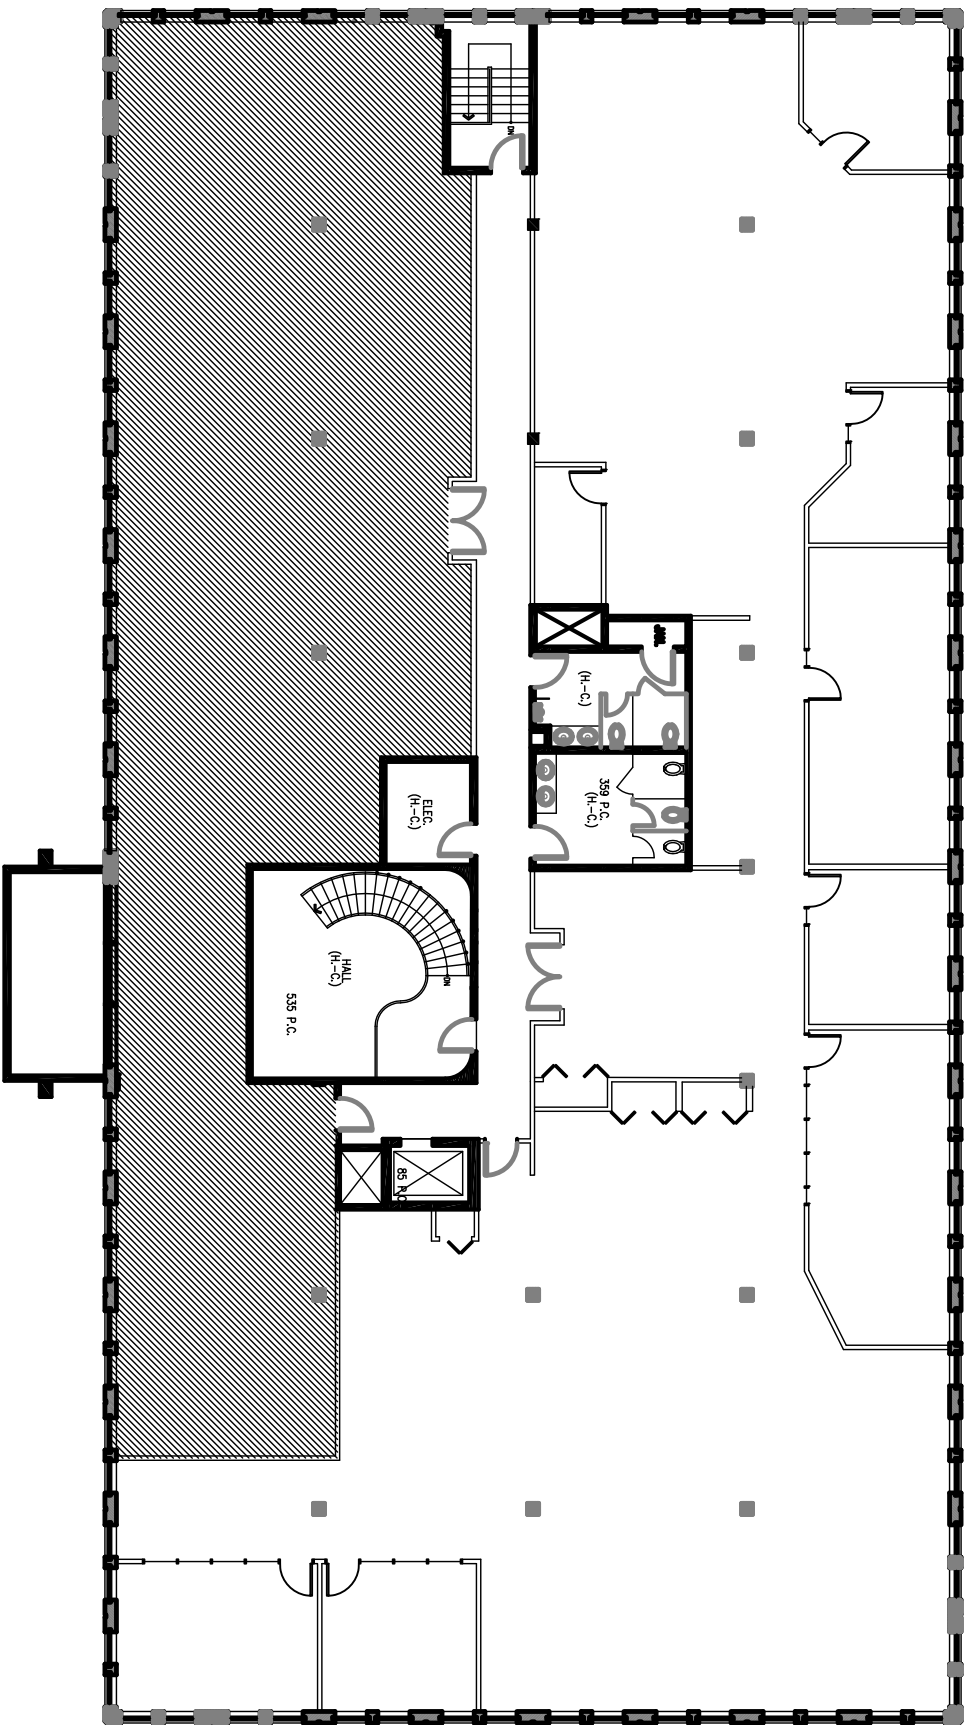

PLAN D'ETAGE / FLOOR PLAN

3 9 5 0 C O T E V E R T U  
V I L L E S T . L A U R E N T

REDBOURNE