


20 986 P.I.C.A

500

20 986 SQ.FT.

SUITE

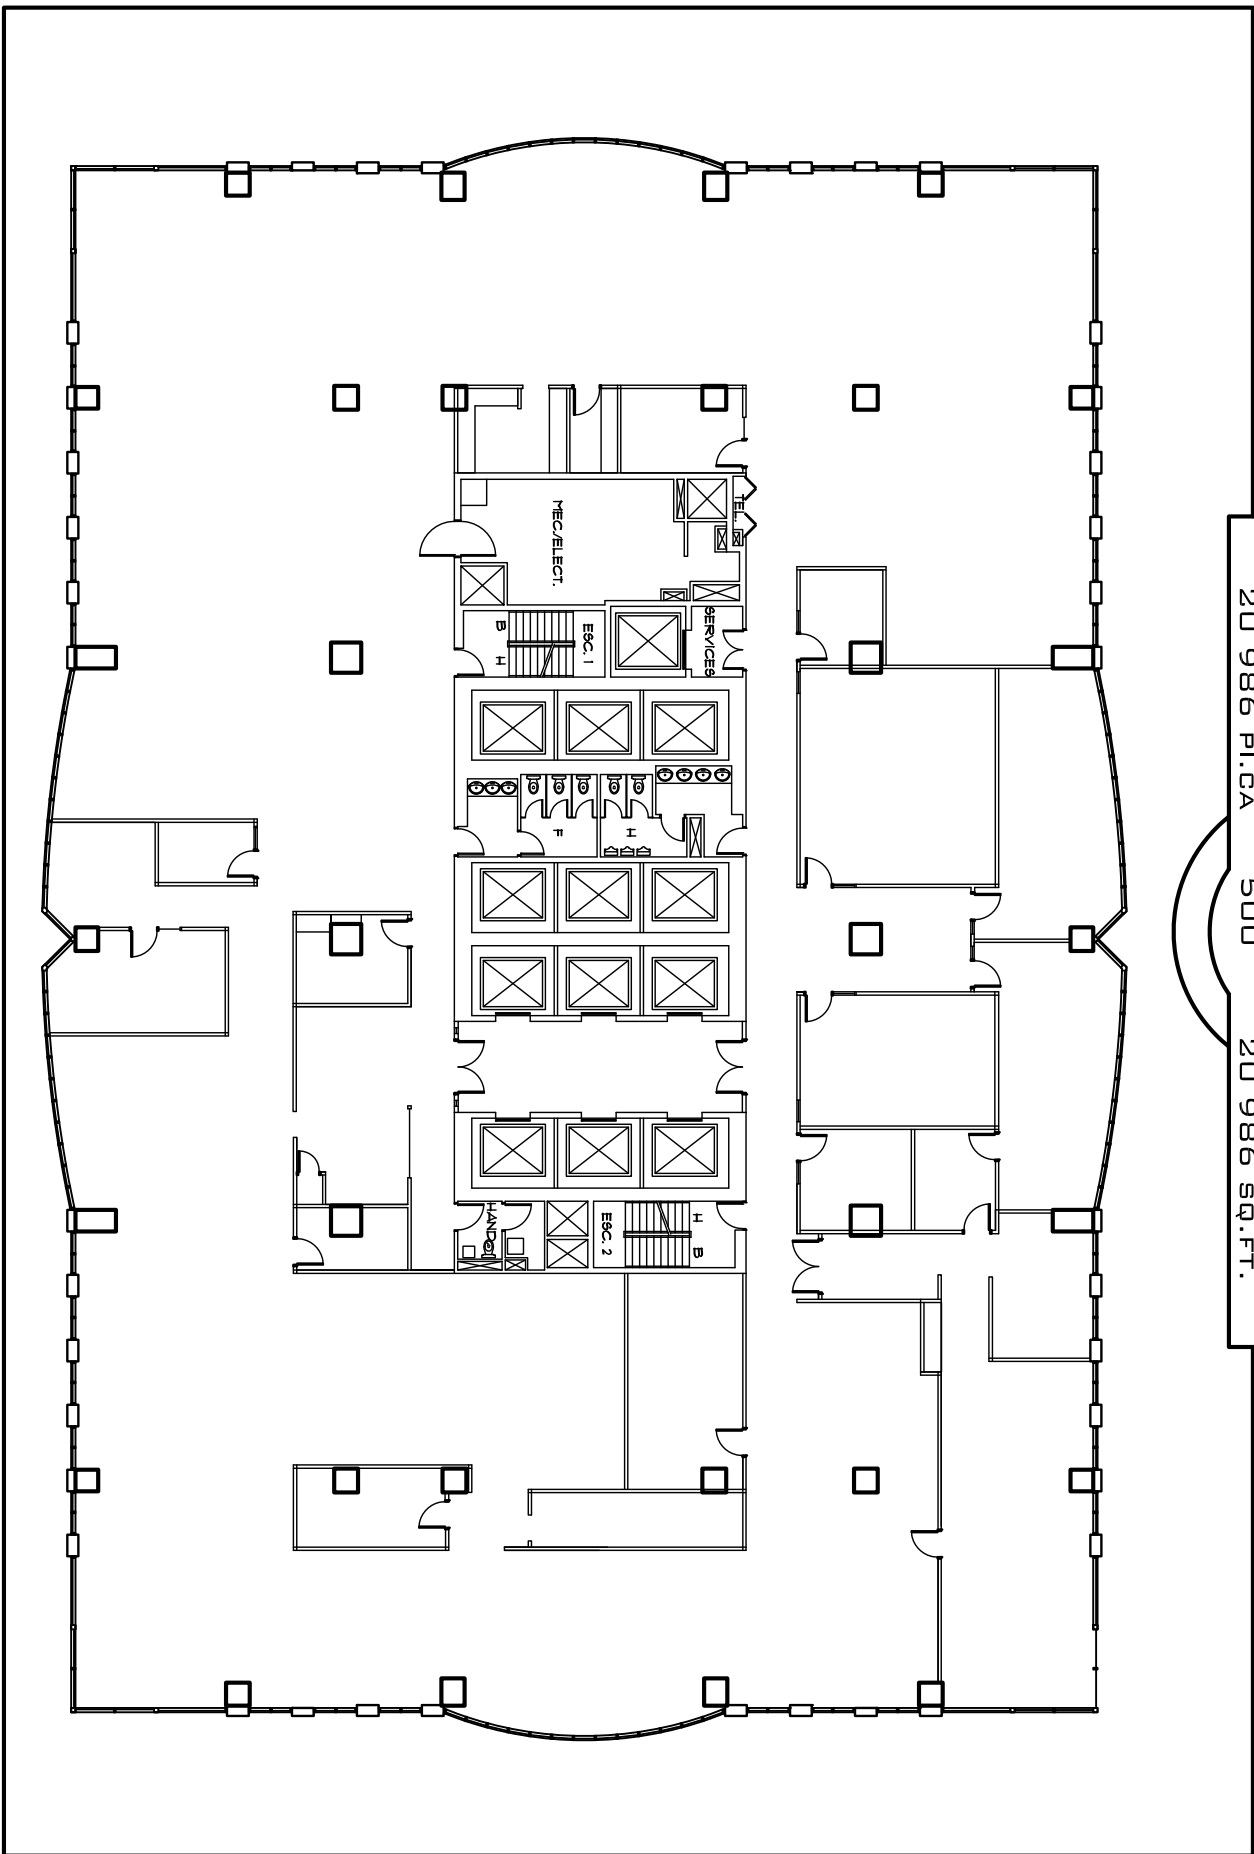

TEL QU'EXISTANT / AS BUILT

1800 MCGILL COLLEGE  
PLACE MONTREAL TRUST

REDBOURNE