


3437 P.I.C.A.

SUITE
1800

3437 SQ.FT.

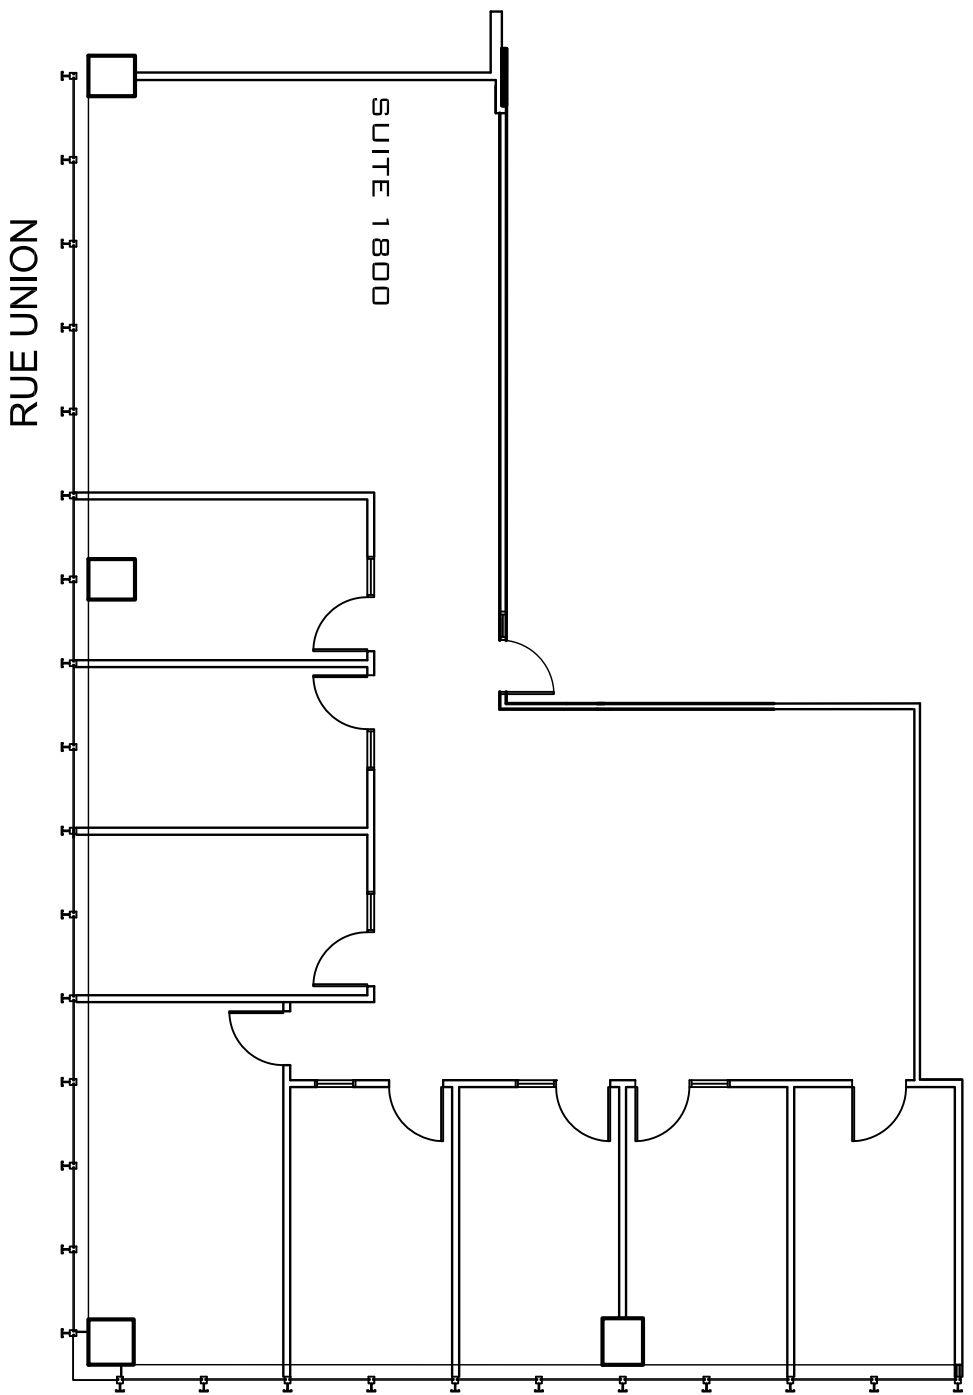

TEL QUÉBEC

630 R. RENÉ-LÉVESQUE O.

