

1 444 P.I.C.A


M-10

1 444 P.I.C.A

SUITE

RUE UNION

VACANT

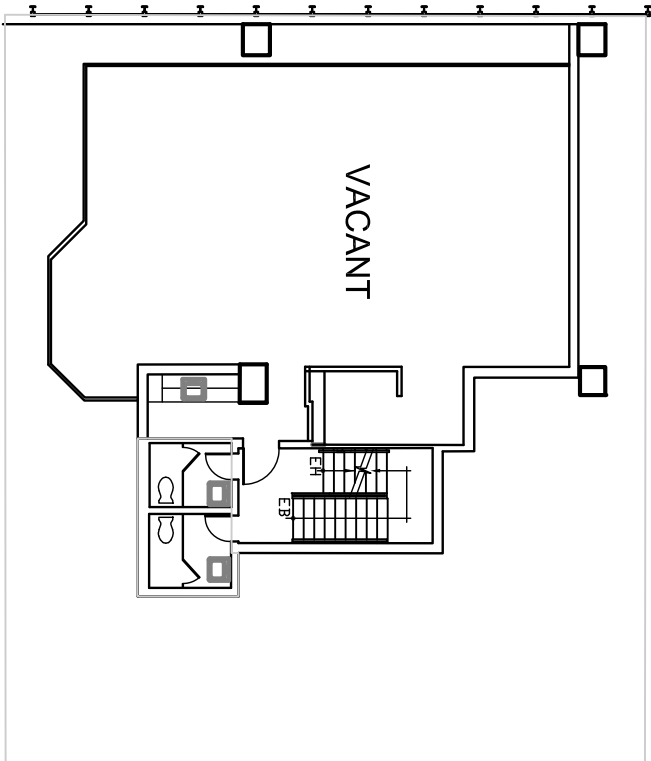

AS BUILT PLAN

630 RENÉ-LÉVESQUE O.

REDBOURNE