


+ - 1,182 pl. ca.

SUITE
P-170

+ - 1,182 sq. ft.

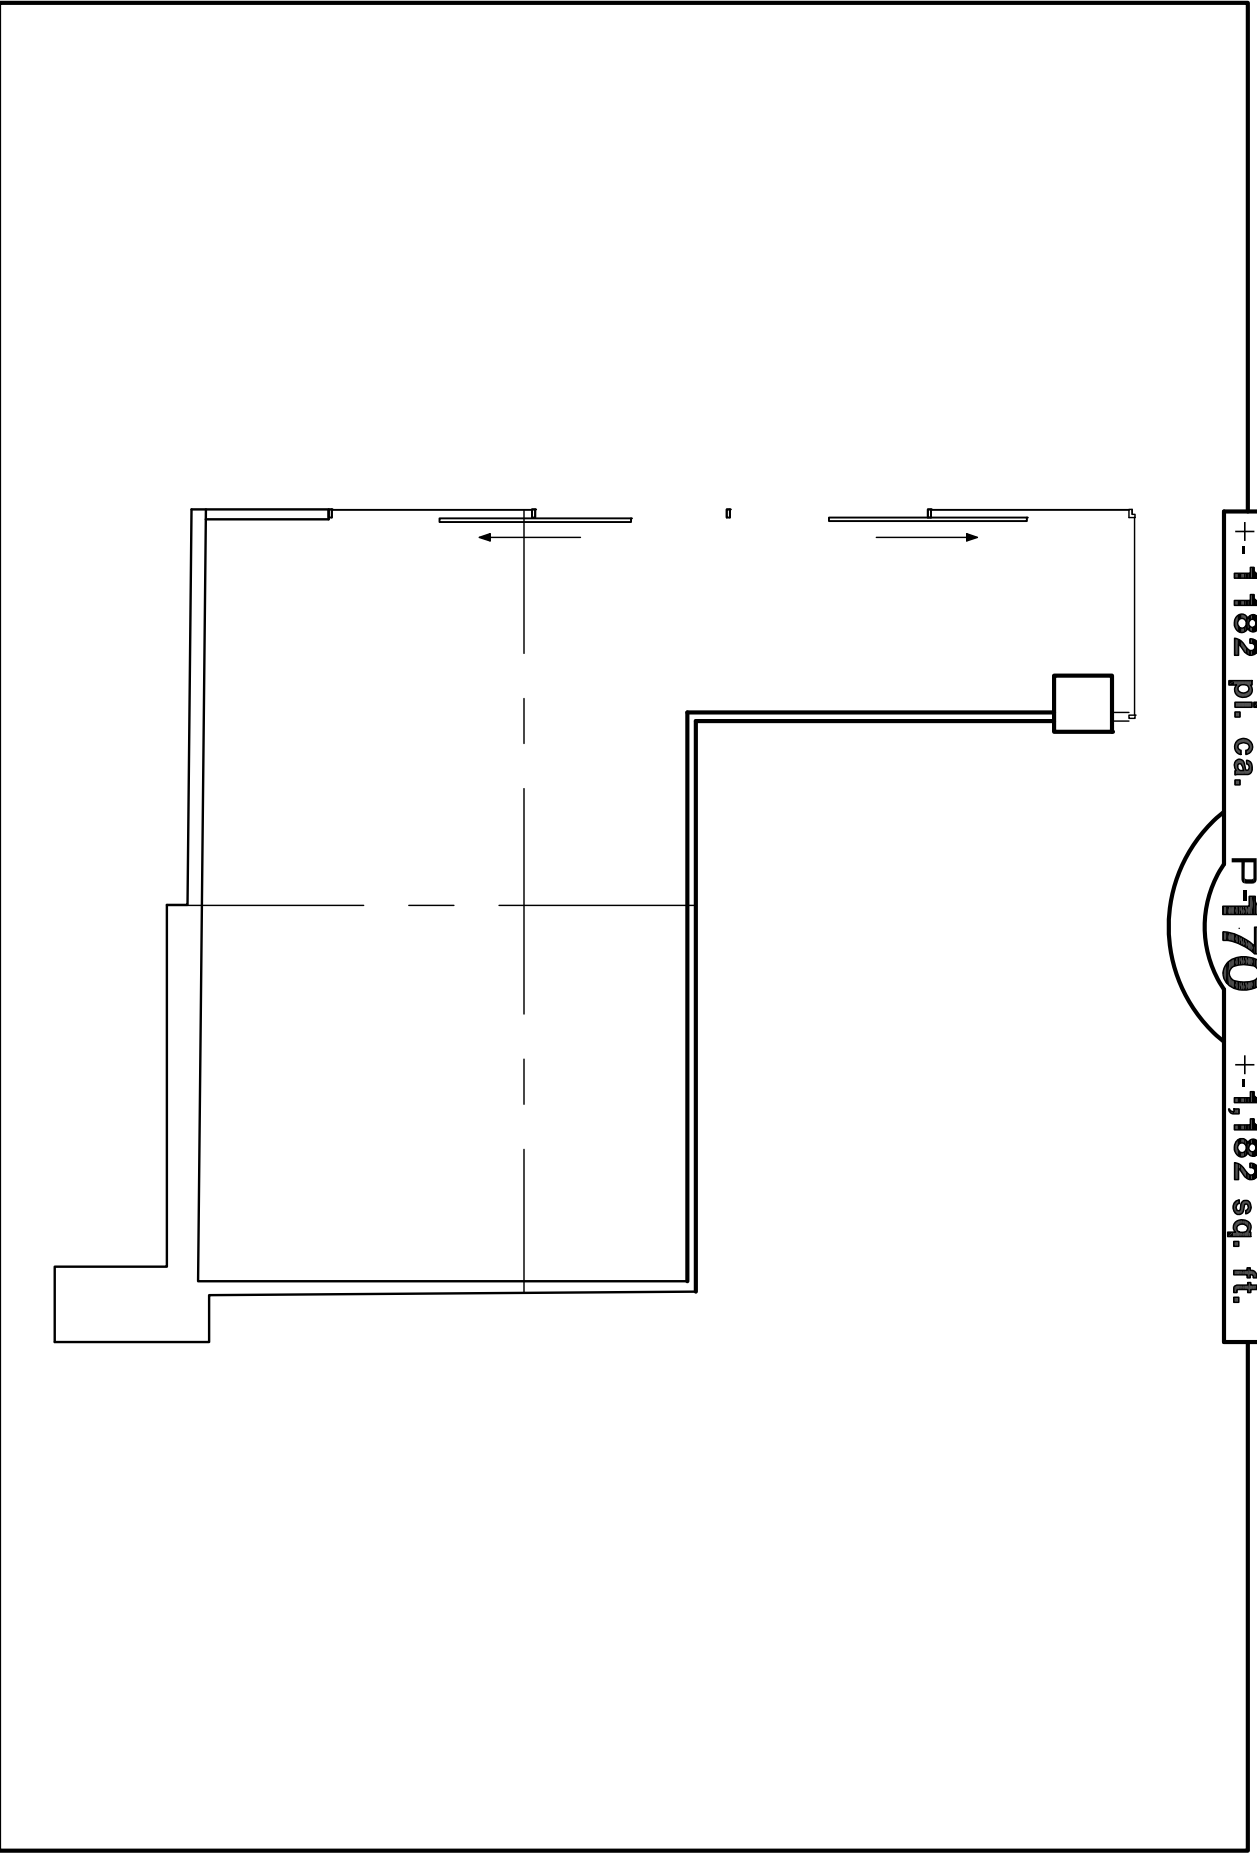

AS BUILT PLAN

630 RENÉ-LÉVESQUE O.

REDBOURNE