


2152 P.I.C.A

SUITE

P-185

2152 P.I.C.A

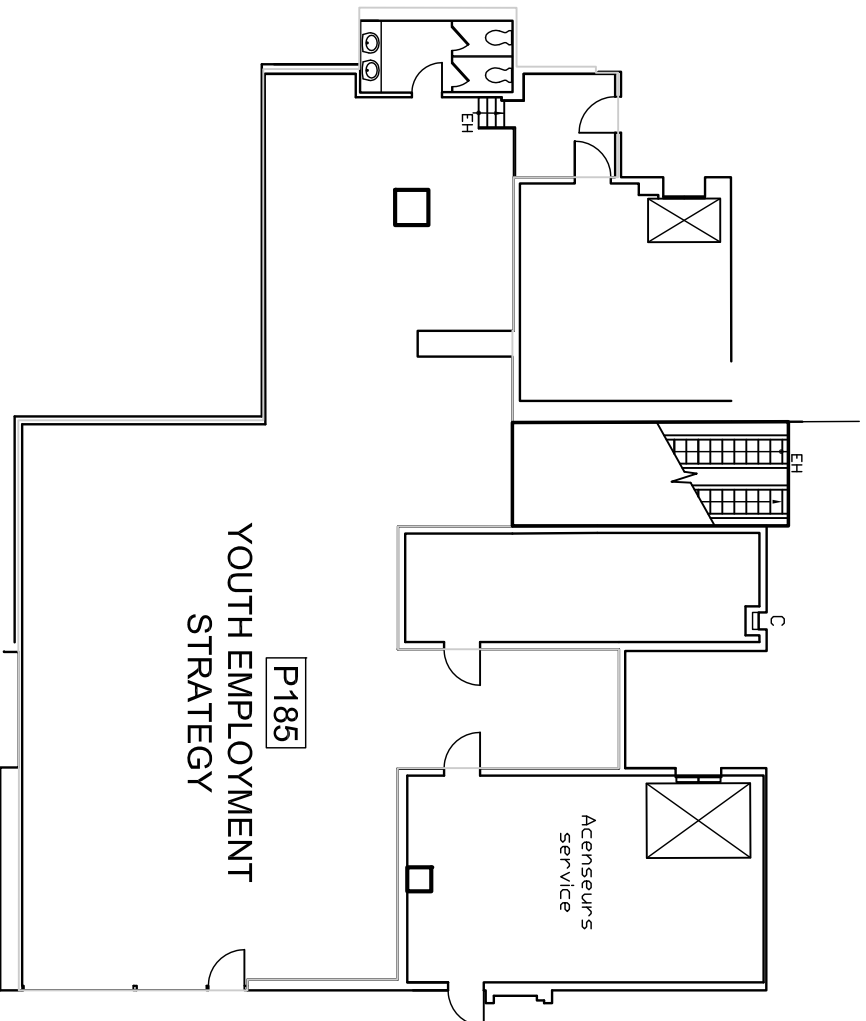

AS BUILT PLAN

630 RENÉ-LÉVESQUE O.

REDBOURNE