


500 P.I.C.A

SUITE

P-180

500 P.I.C.A

RUE UNION

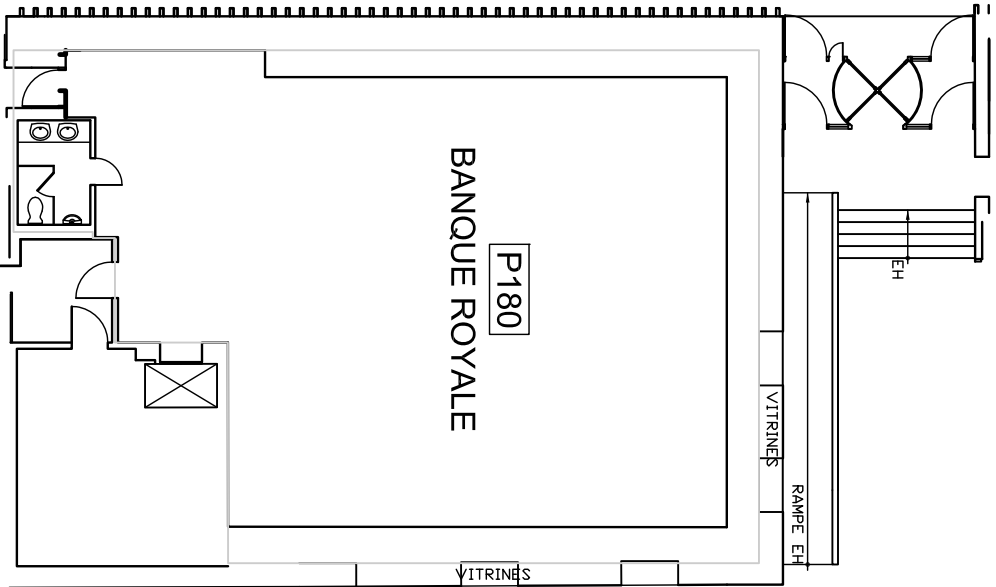

AS BUILT PLAN

630 RENÉ-LÉVESQUE O.

REDBOURNE