


18 959 P.I.C.A

SUITE

100

18 959 SQ.FT

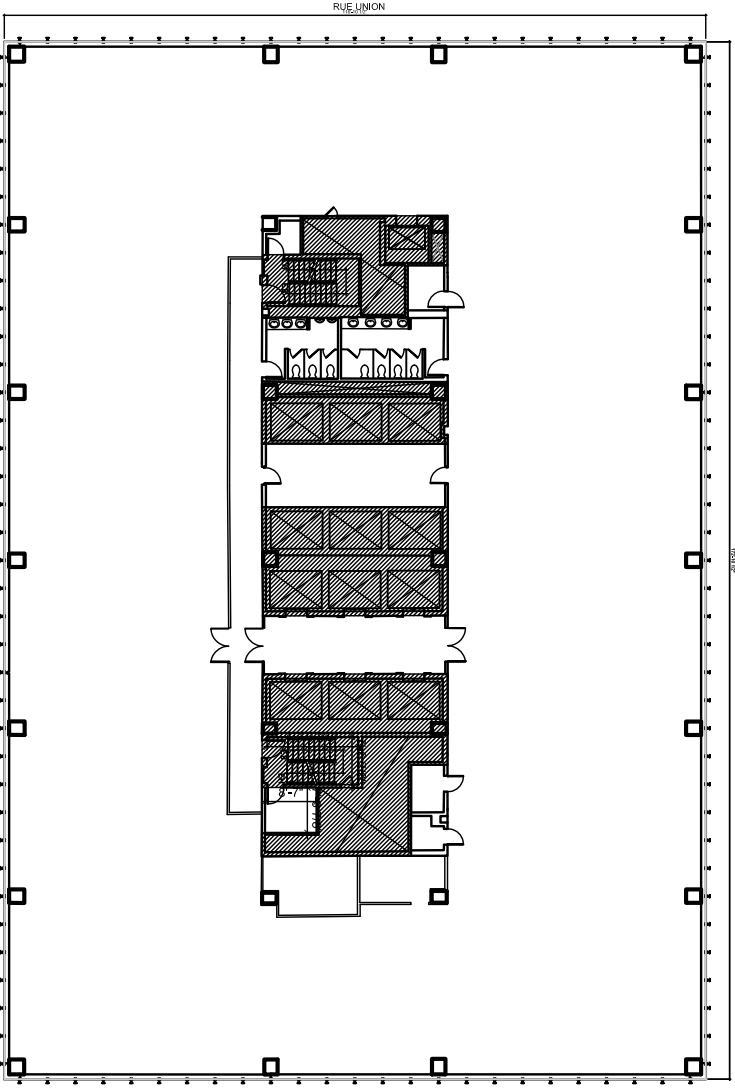

RUE UNION

RUE UNIVERSITY

BOULEVARD RENÉ-LÉVESQUE

AS BUILT PLAN

630 RENÉ-LÉVESQUE O.

REDBOURNE