


3606 P.I.G.A

SUITE
1100

3606 SQ. FT

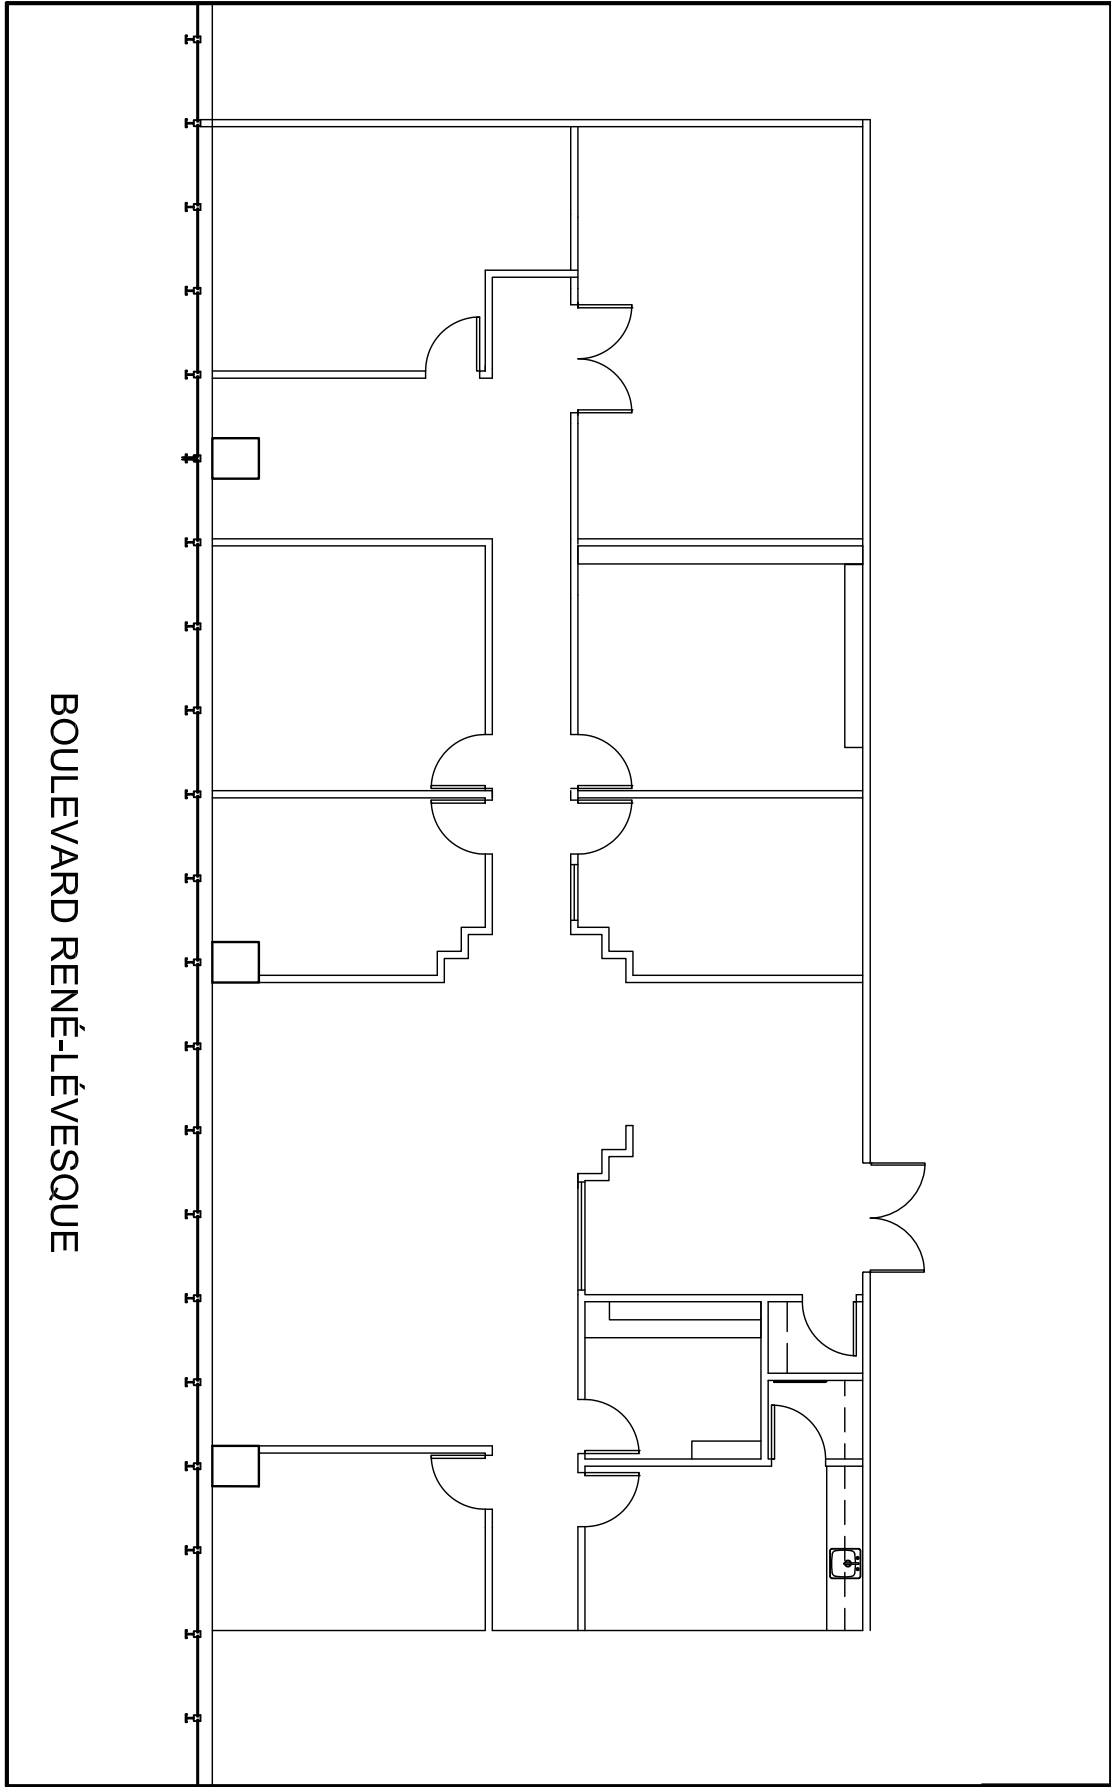

BOULEVARD RENÉ-LÉVESQUE

PLAN TEL QU'EXISTANT/AS BUILT PLAN

630 RENÉ-LÉVESQUE O.

