


4015 pl. G.

SUITE

1201

4015 sq. ft.

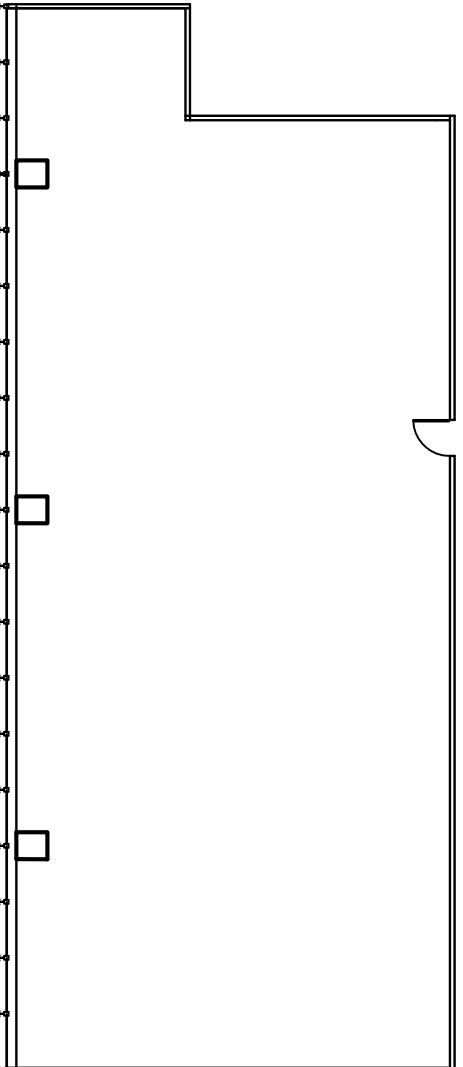

BOULEVARD RENÉ-LÉVESQUE

FLOOR LOCATION

630 RENÉ-LÉVESQUE O.

REDBOURNE