


2377 P.I.C.A.

SUITE

1661

2377 SQ.FT.

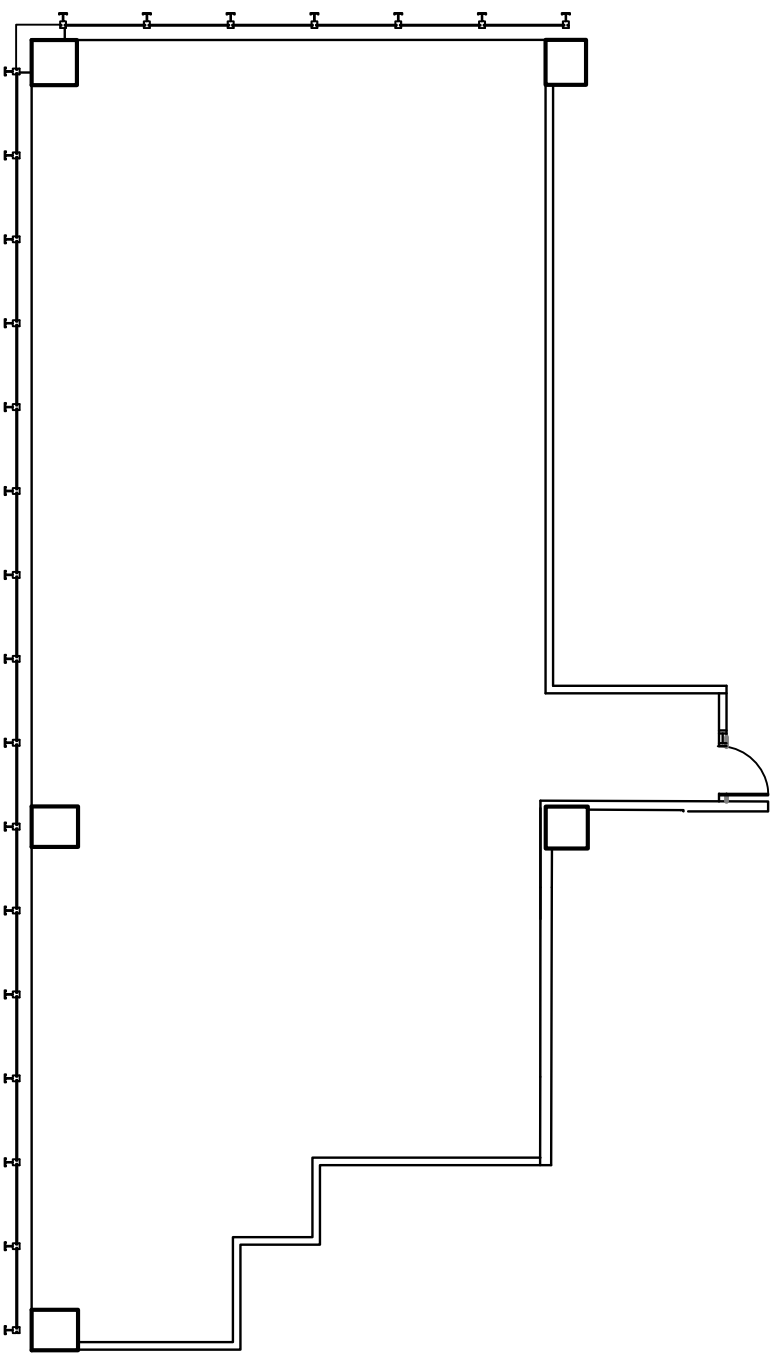

RUE UNION

TEL QUEL

630 RENÉ-LÉVESQUE O.

REDBOURNE