


1 231 P.I.C.A

SUITE

1 701

1 231 P.I.C.A

RUE UNION

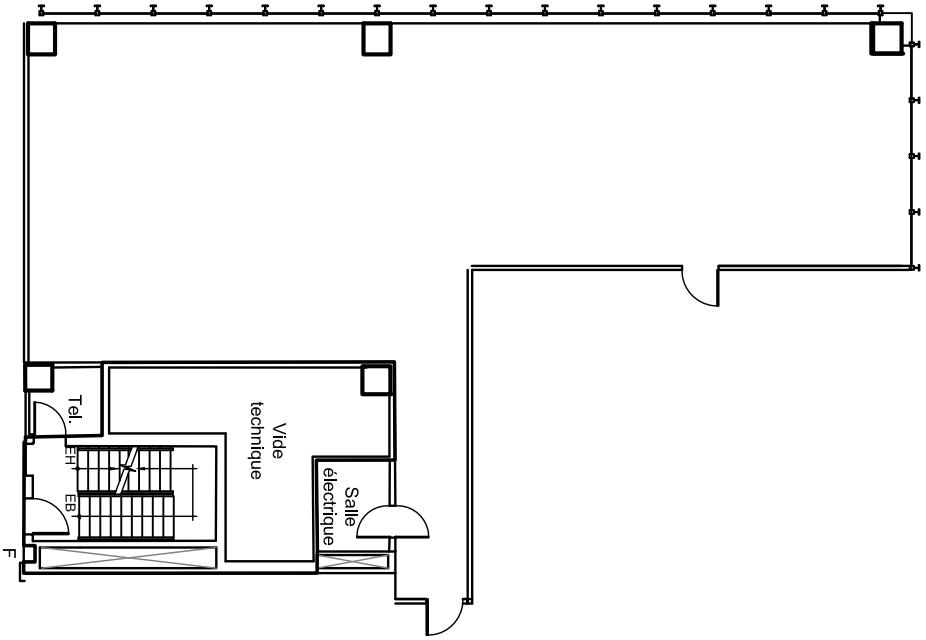

AS BUILT PLAN

6 3 0 R E N É - L É V E S Q U E O .

REDBOURNE