


670 P.I.CA
SUITE
1830-1
670 SQ.FT

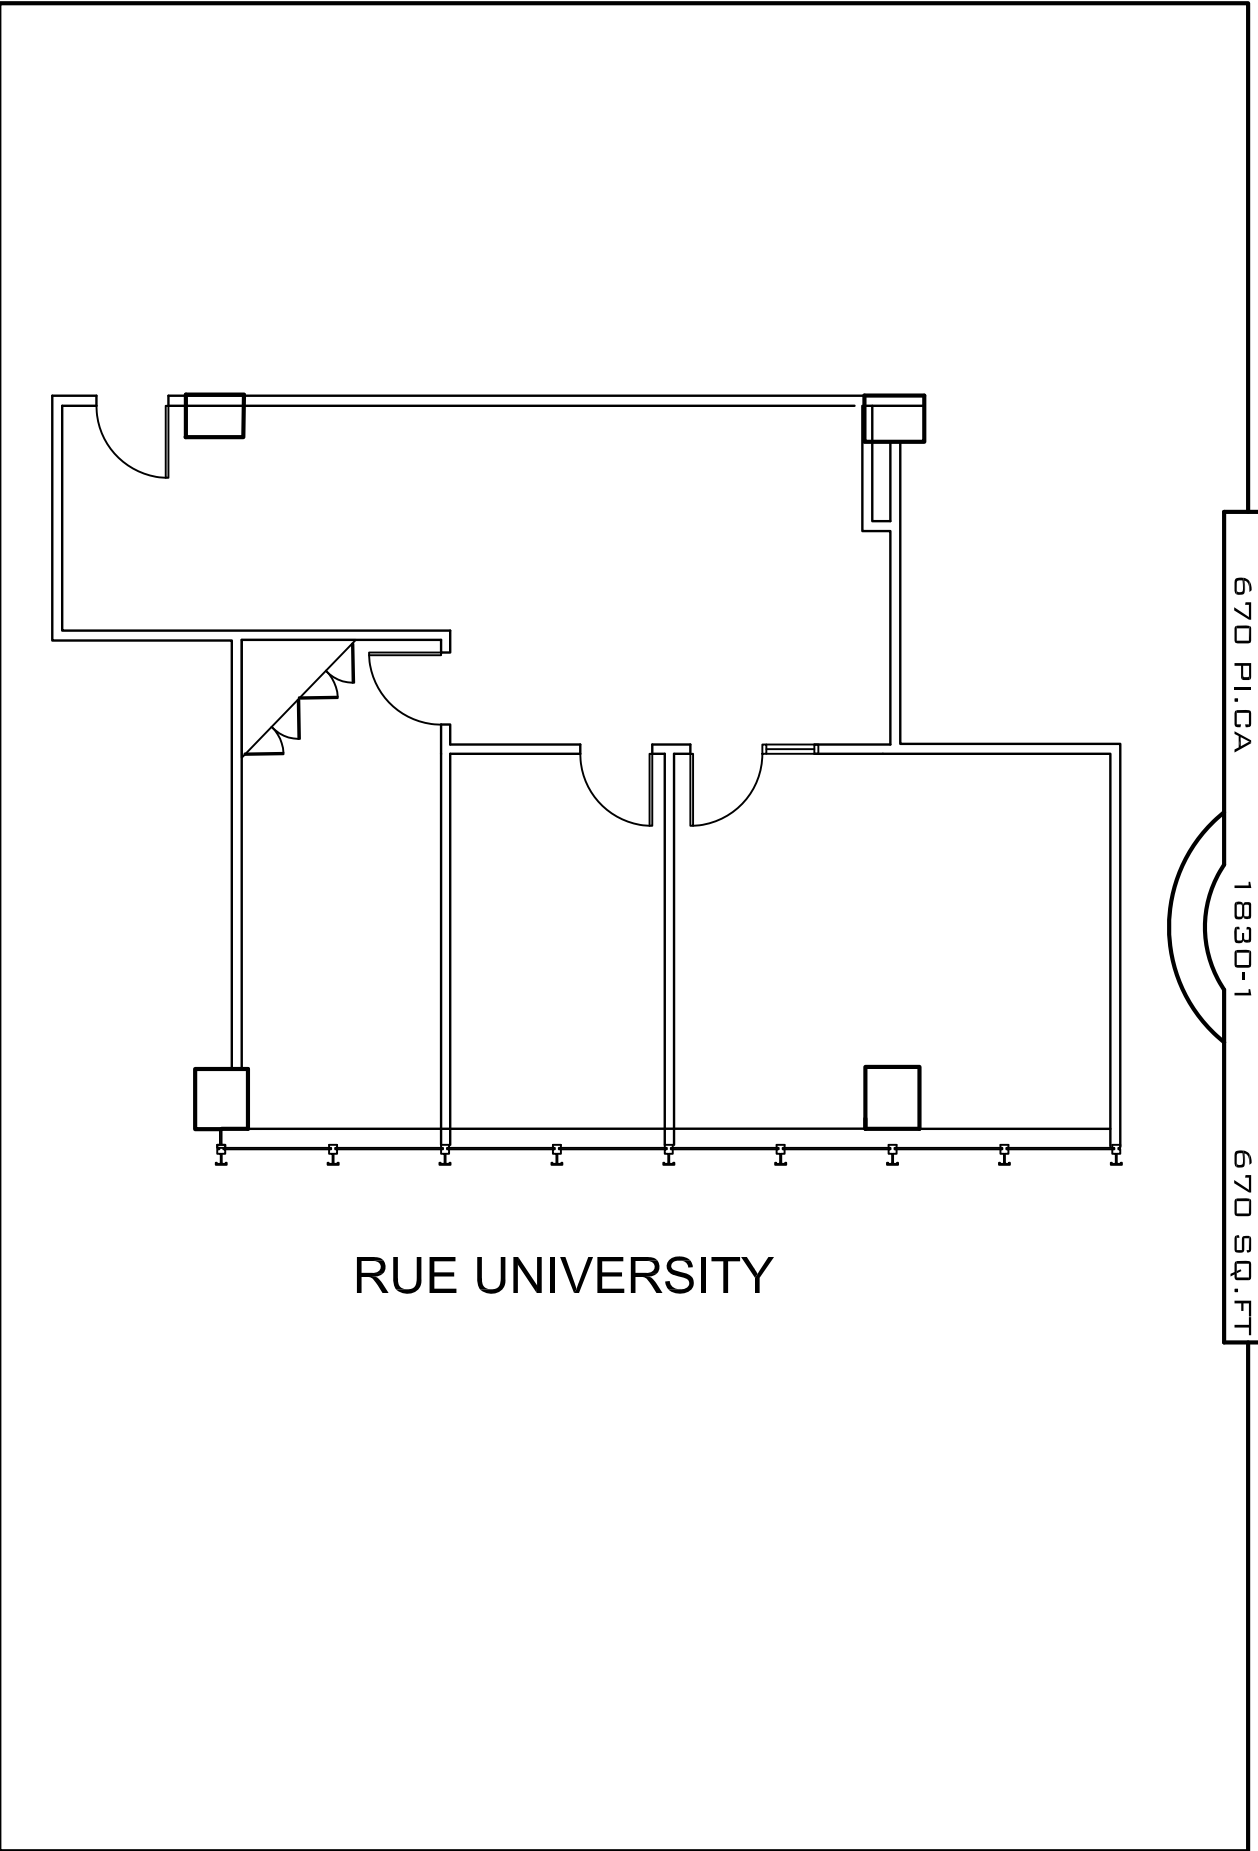

RUE UNIVERSITY

TEL QUEL/AS BUILT

630 RENÉ-LÉVESQUE O.

