


19 532 P.I.C.A

2000

19 532 SQ.FT

SUITE

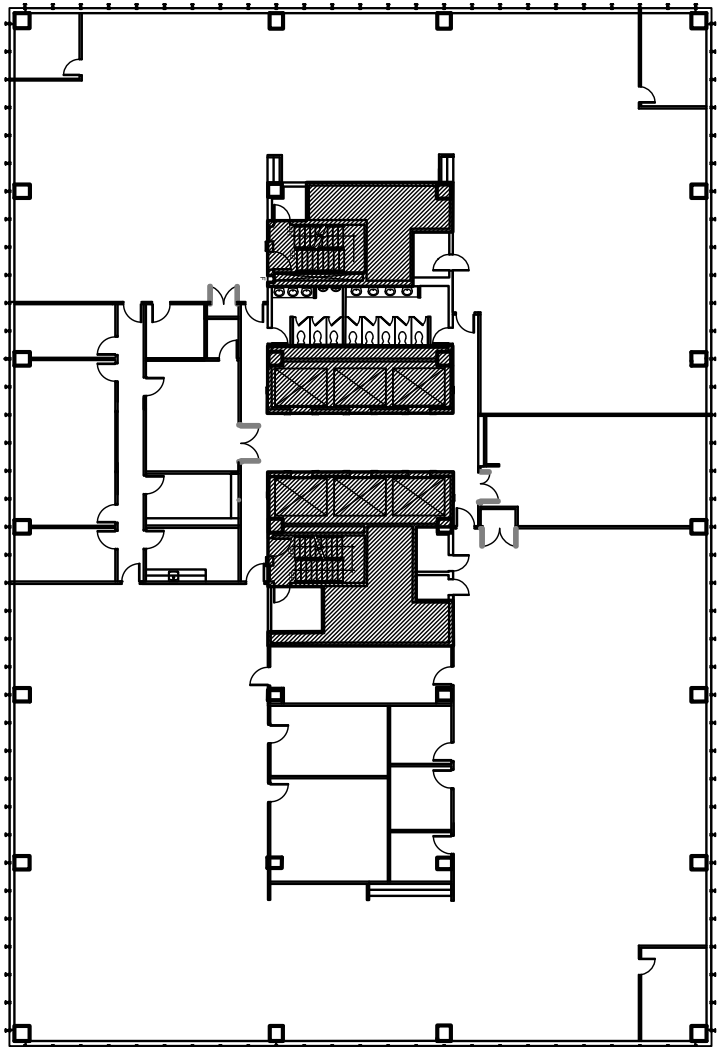

AS BUILT PLAN

630 RENÉ-LÉVESQUE O.

REDBOURNE