


2062 pl. ca.

SUITE

2320

2062 sq. ft.

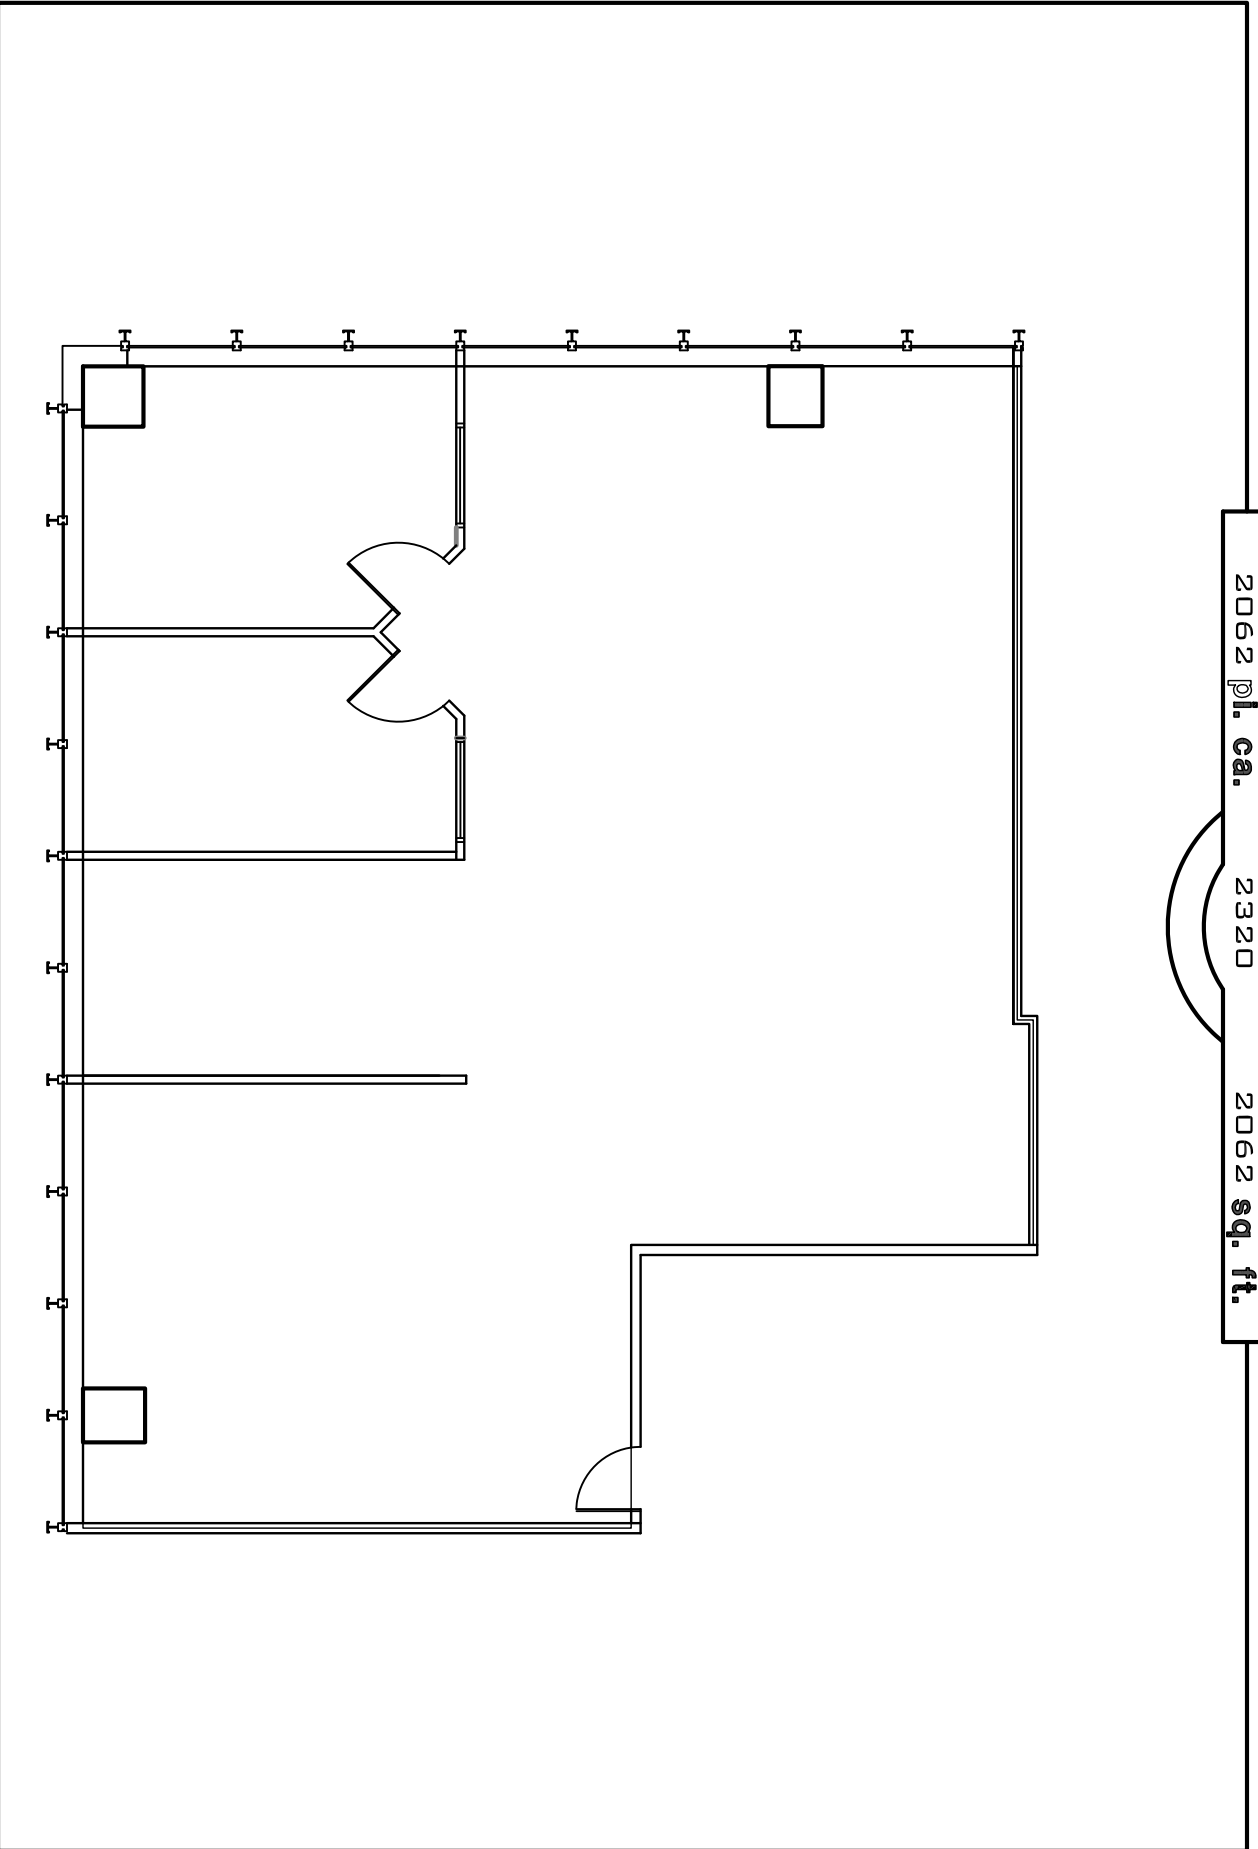

TEL QUEL

630 RENÉ-LÉVESQUE O.

REDBOURNE