


3375 PL.GA

SUITE
2700

3375 SQ.FT

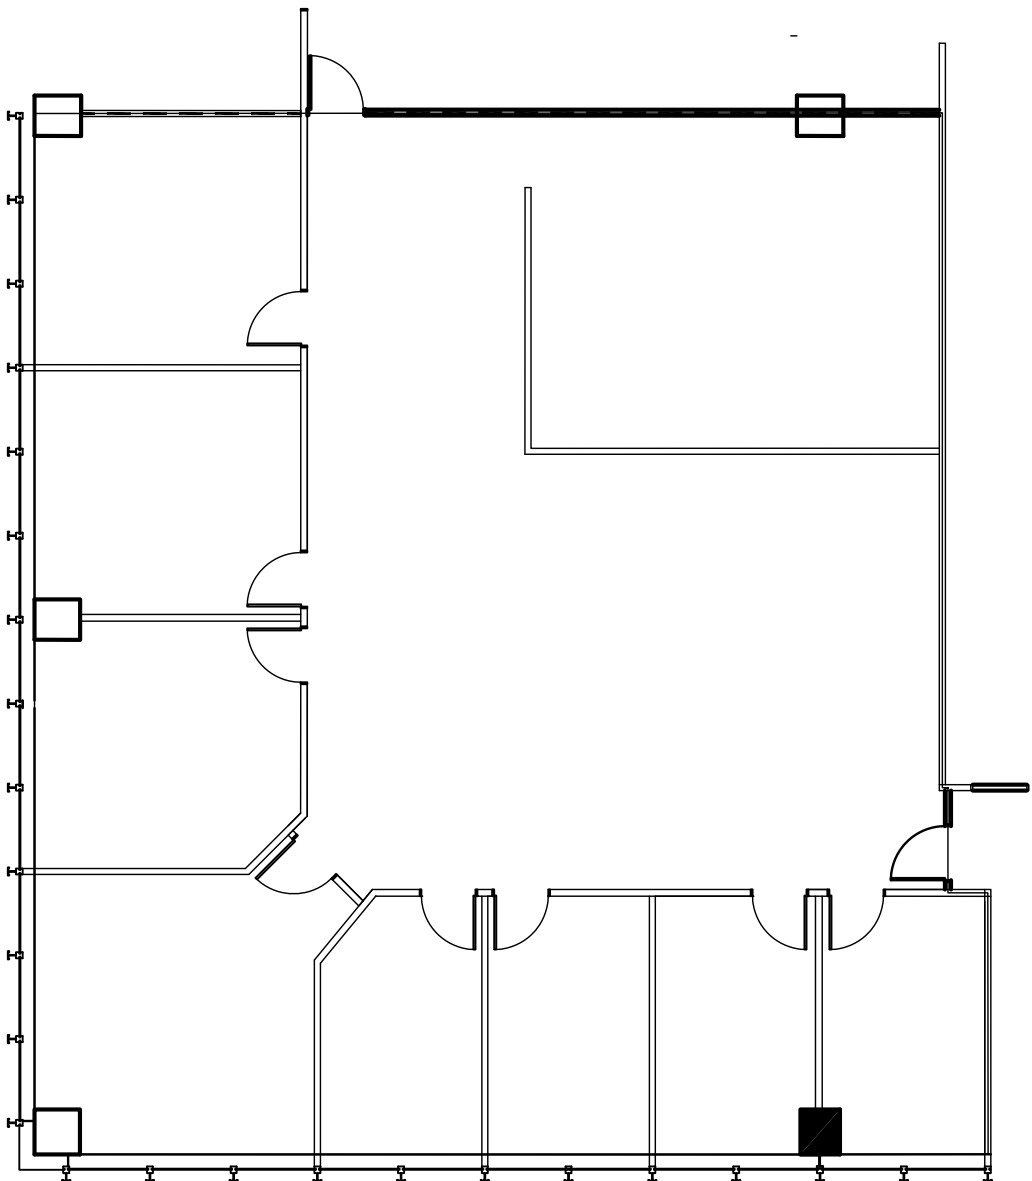

AS BUILT PLAN

630 RENÉ-LÉVESQUE O.

REDBOURNE