


1137 pl. ca.

2800

1137 sq. ft.

SUITE

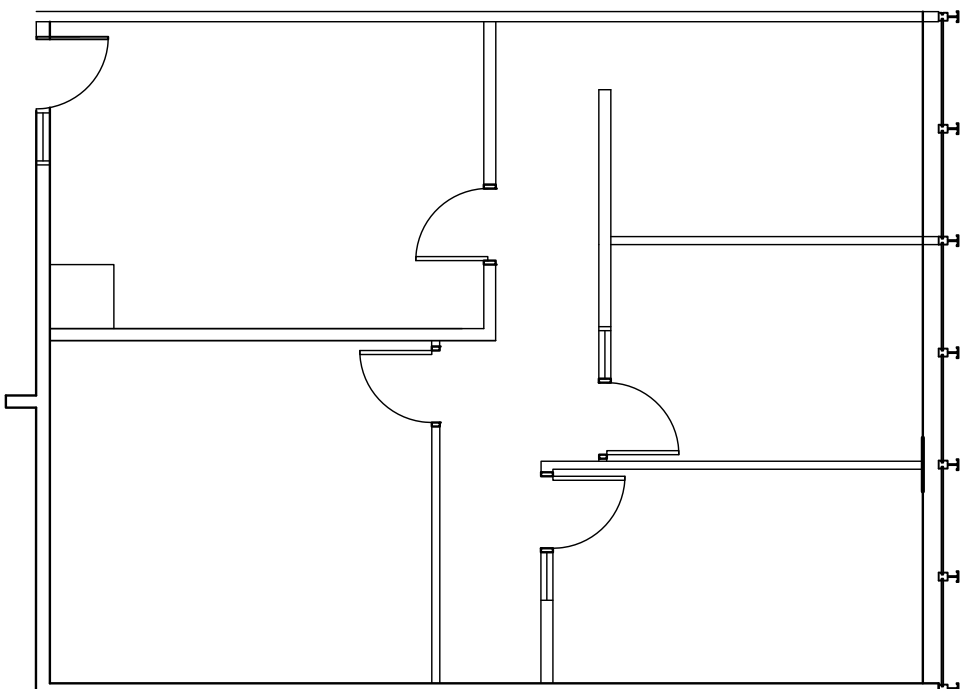

TEL QUEL / AS BUILT

630 RENÉ-LÉVESQUE D.

REDBOURNE