


2238 P.I.C.A

SUITE  
2855

2238 SQ.FT

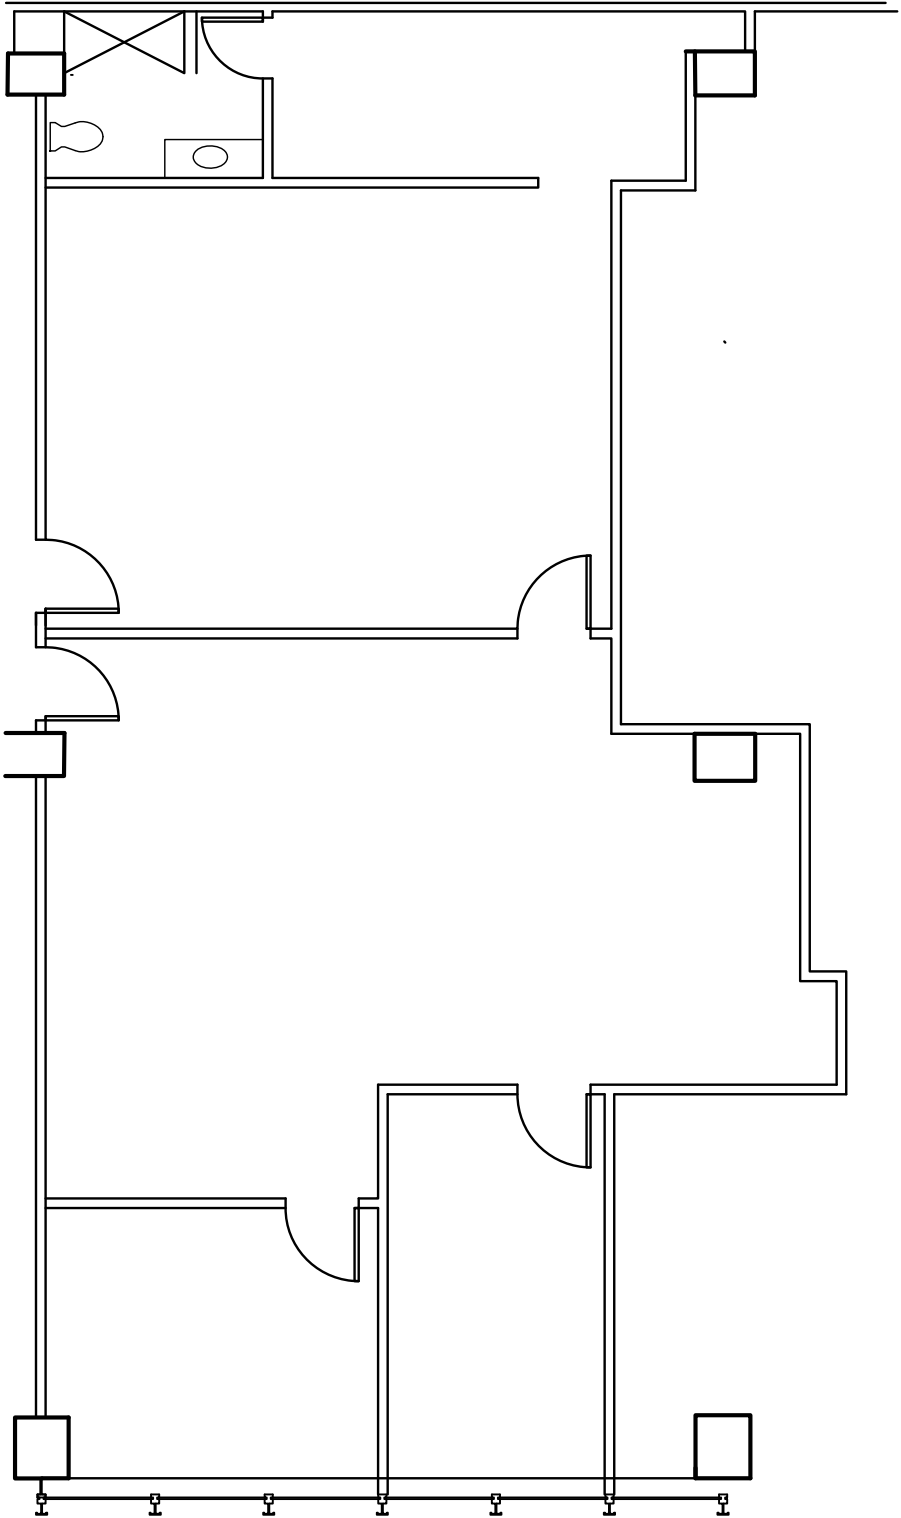

RUE UNIVERSITY

AS BUILT PLAN

630 RENÉ-LÉVESQUE O.

REDBOURNE