


+- 1373 pl. ca.

SUITE

2930

+- 1373 sq. ft.

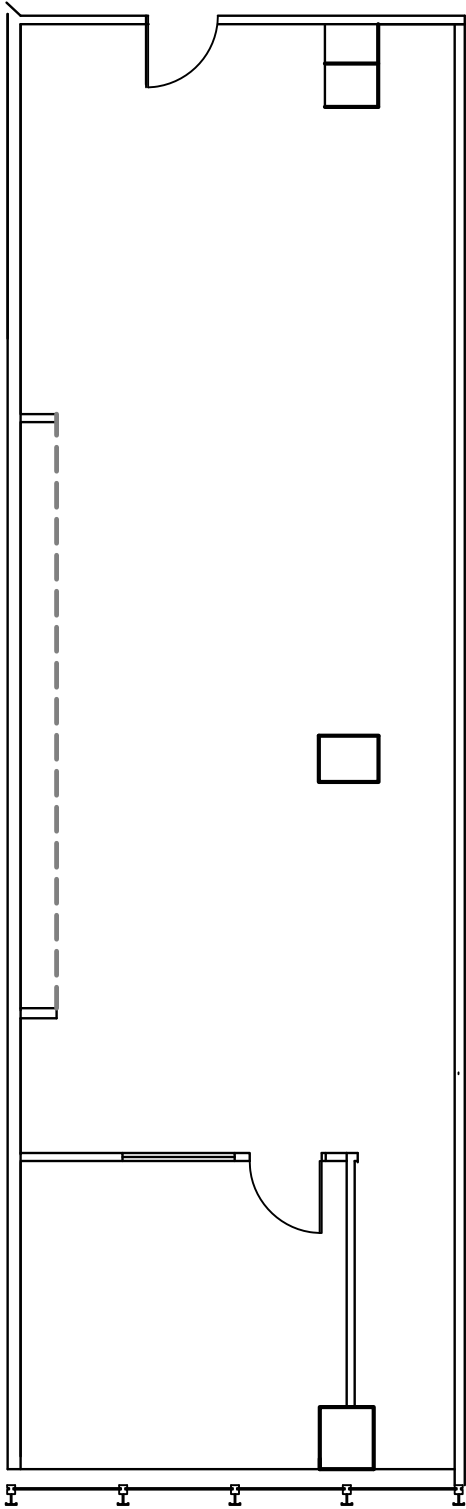

RUE UNIVERSITY

AS BUILT

630 RENÉ-LÉVESQUE O.

REDBOURNE