


19 545 P1 CA

3000

19 545 SQ FT

SUITE

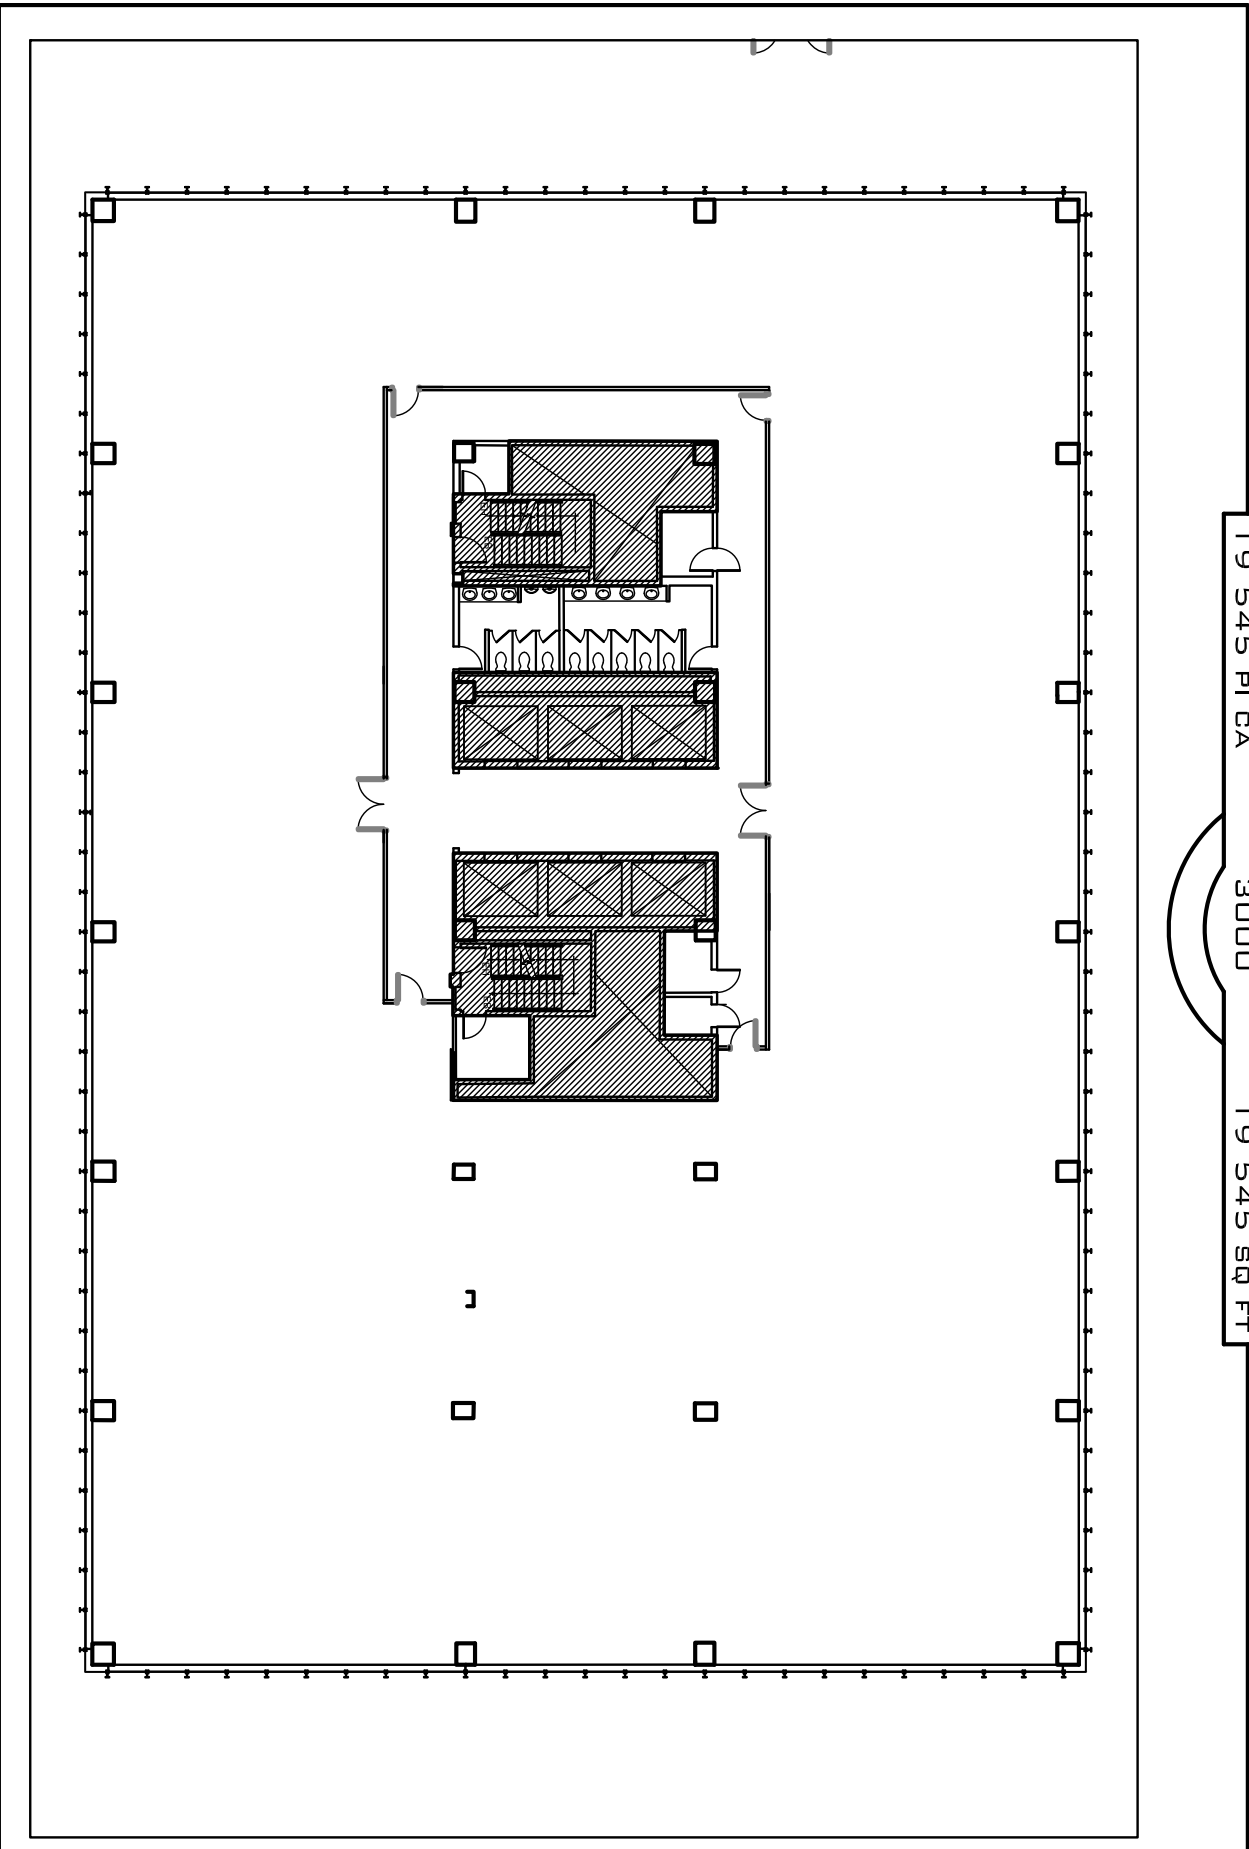

TEL QU'EXISTANT /AS BUILT

630 RENÉ-LÉVESQUE O.

REDBOURNE