


1 1 631 PICA

SUITE

3100

1 1 631 SQ FT

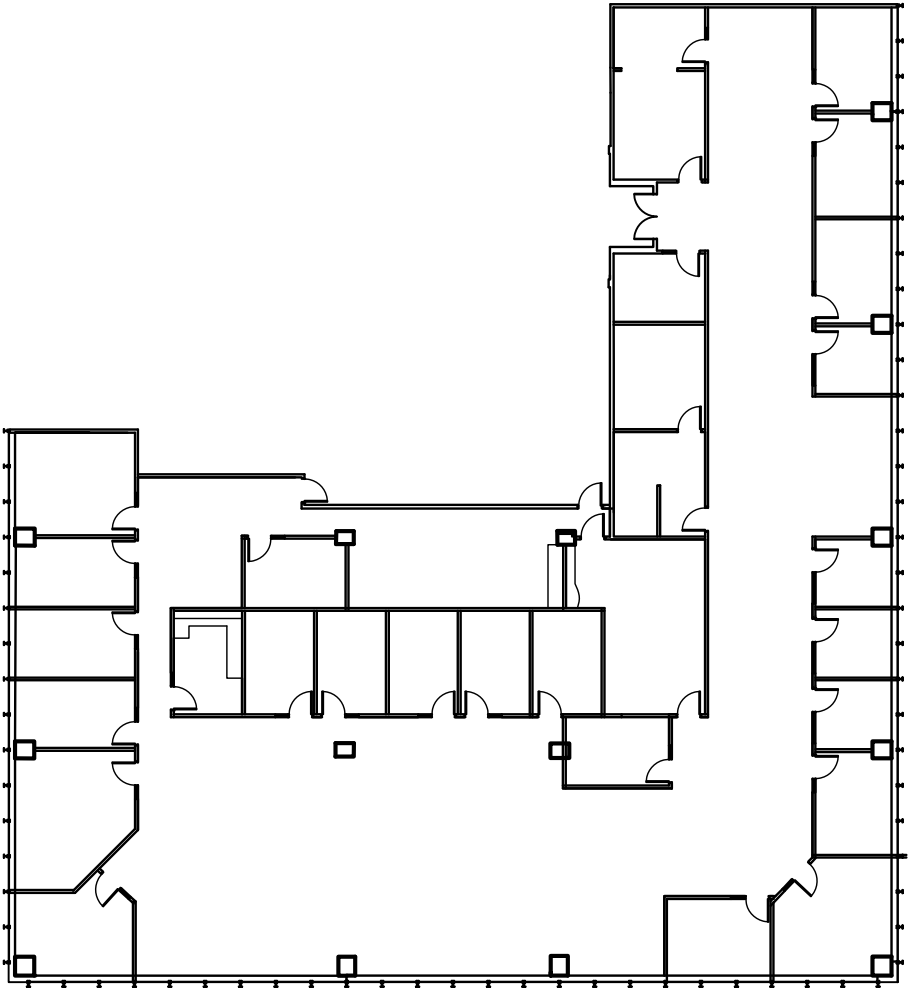

BOULEVARD RENÉ-LÉVESQUE

RUE UNIVERSITY

TEL QU'EXISTANT / AS BUILT

630 RENÉ-LÉVESQUE O.

REDBOURNE