

SUITE


± 2 800 pi. ca.

208

± 2 800 sq. ft.

7355 TRANS-CANADA

Route Transcanadienne

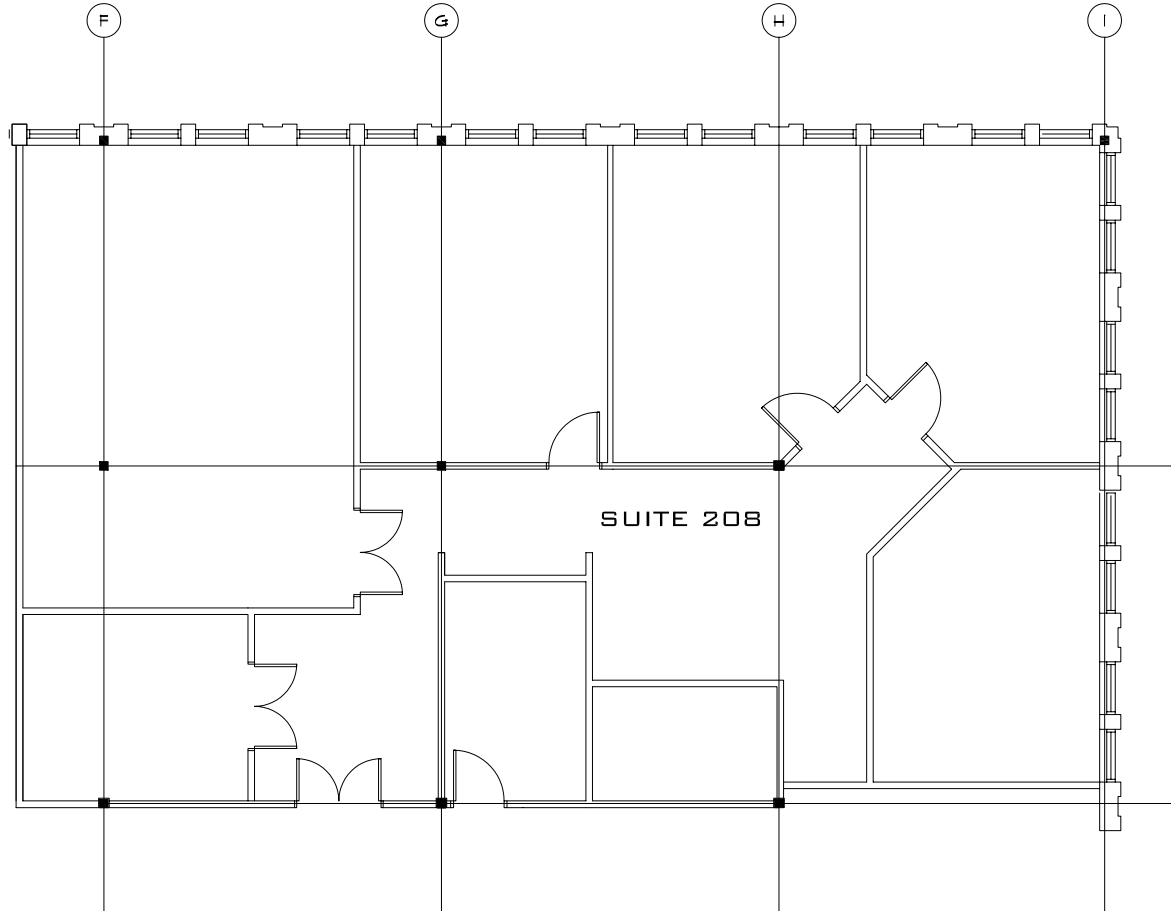

REDBOURNE

AS BUILT PLAN - TEL QUE CONSTRUIT
7355 TRANS-CANADA - VILLE ST. LAURENT