


2 793 pi. ca.

SUITE

208

2 793 sq. ft.

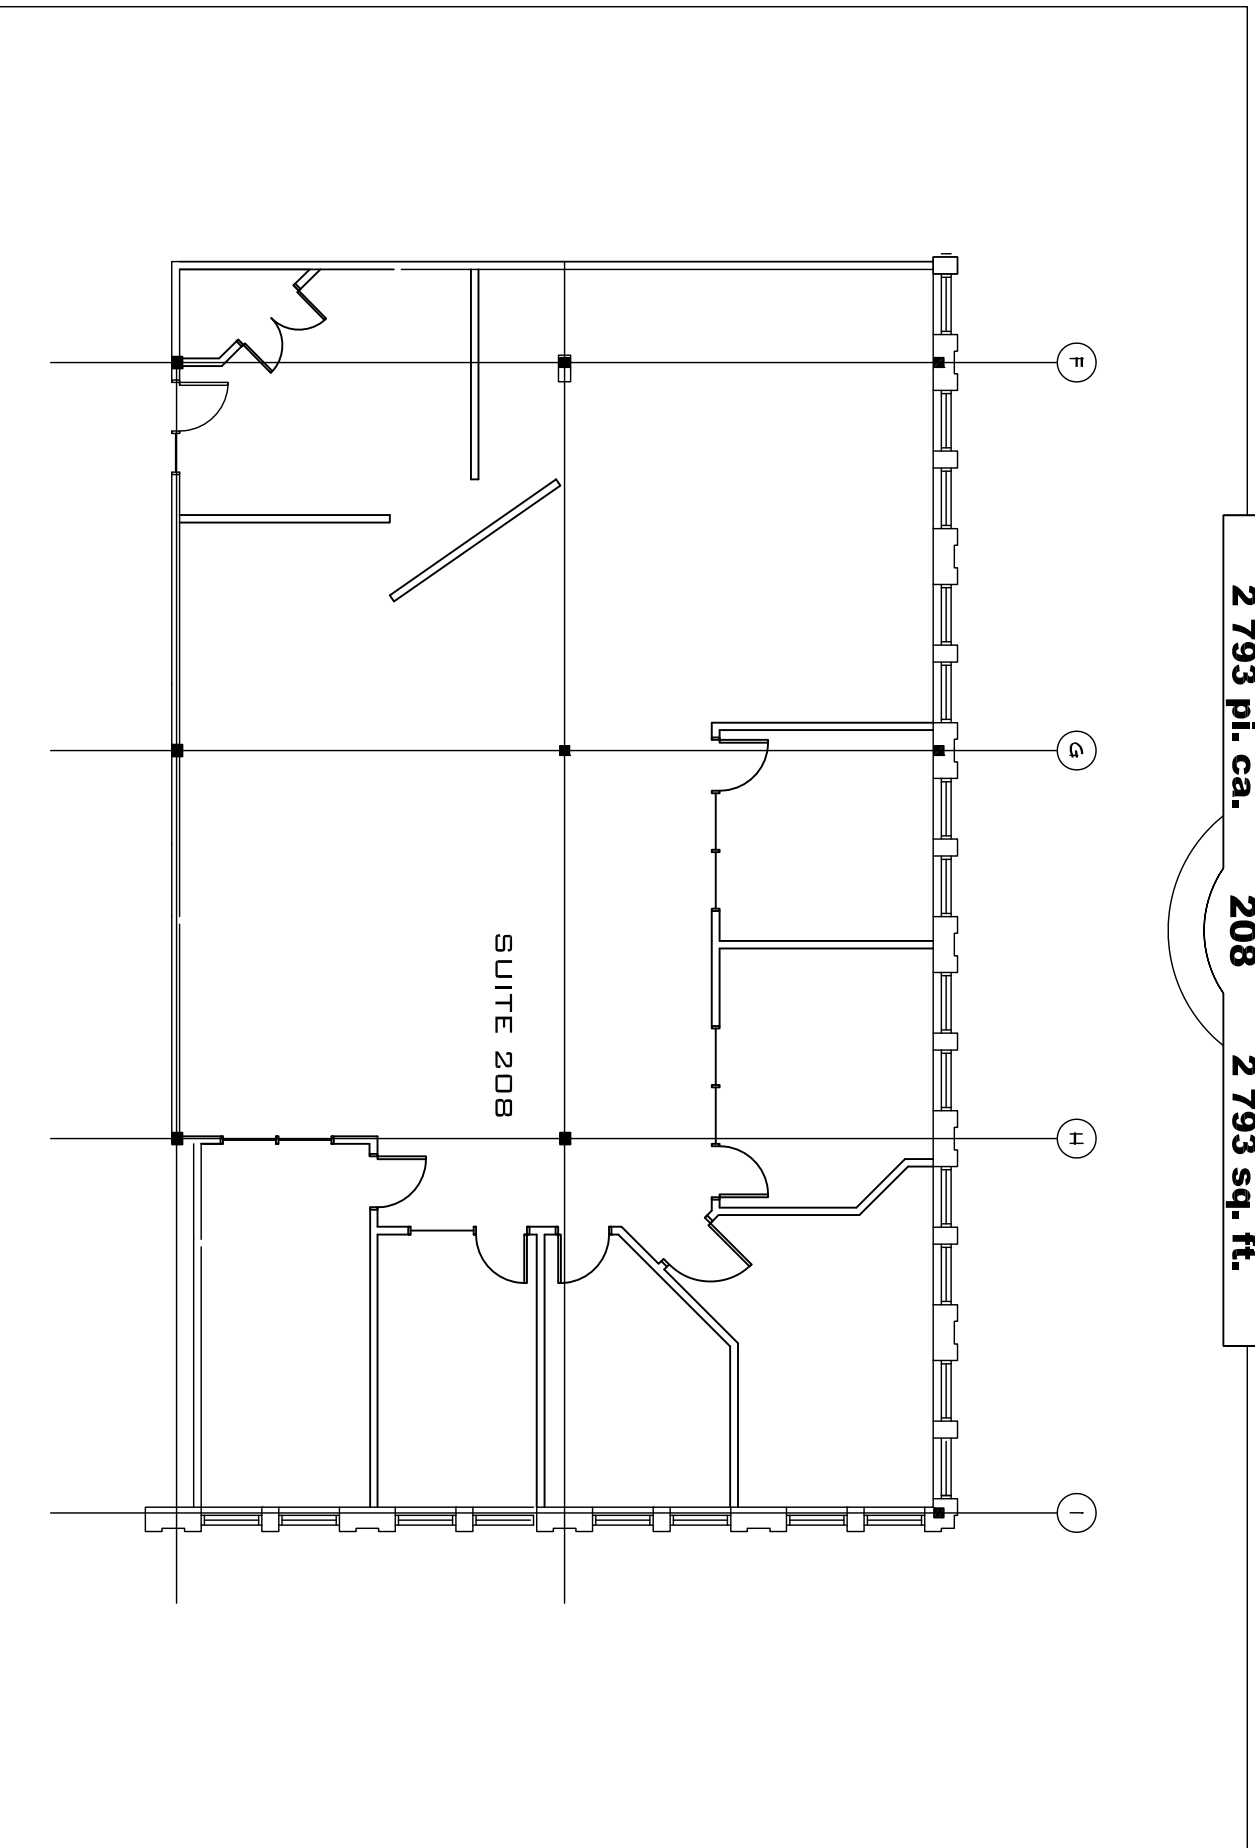

TEL QU'EXISTANT / AS BUILT PLAN

7 3 5 5 T R A N S - C A N A D A
V I L L E S T . L A U R E N T

REDBOURNE