


*

6 602.59P.I.CA

SUITE
201

6 602.59SQ.FT

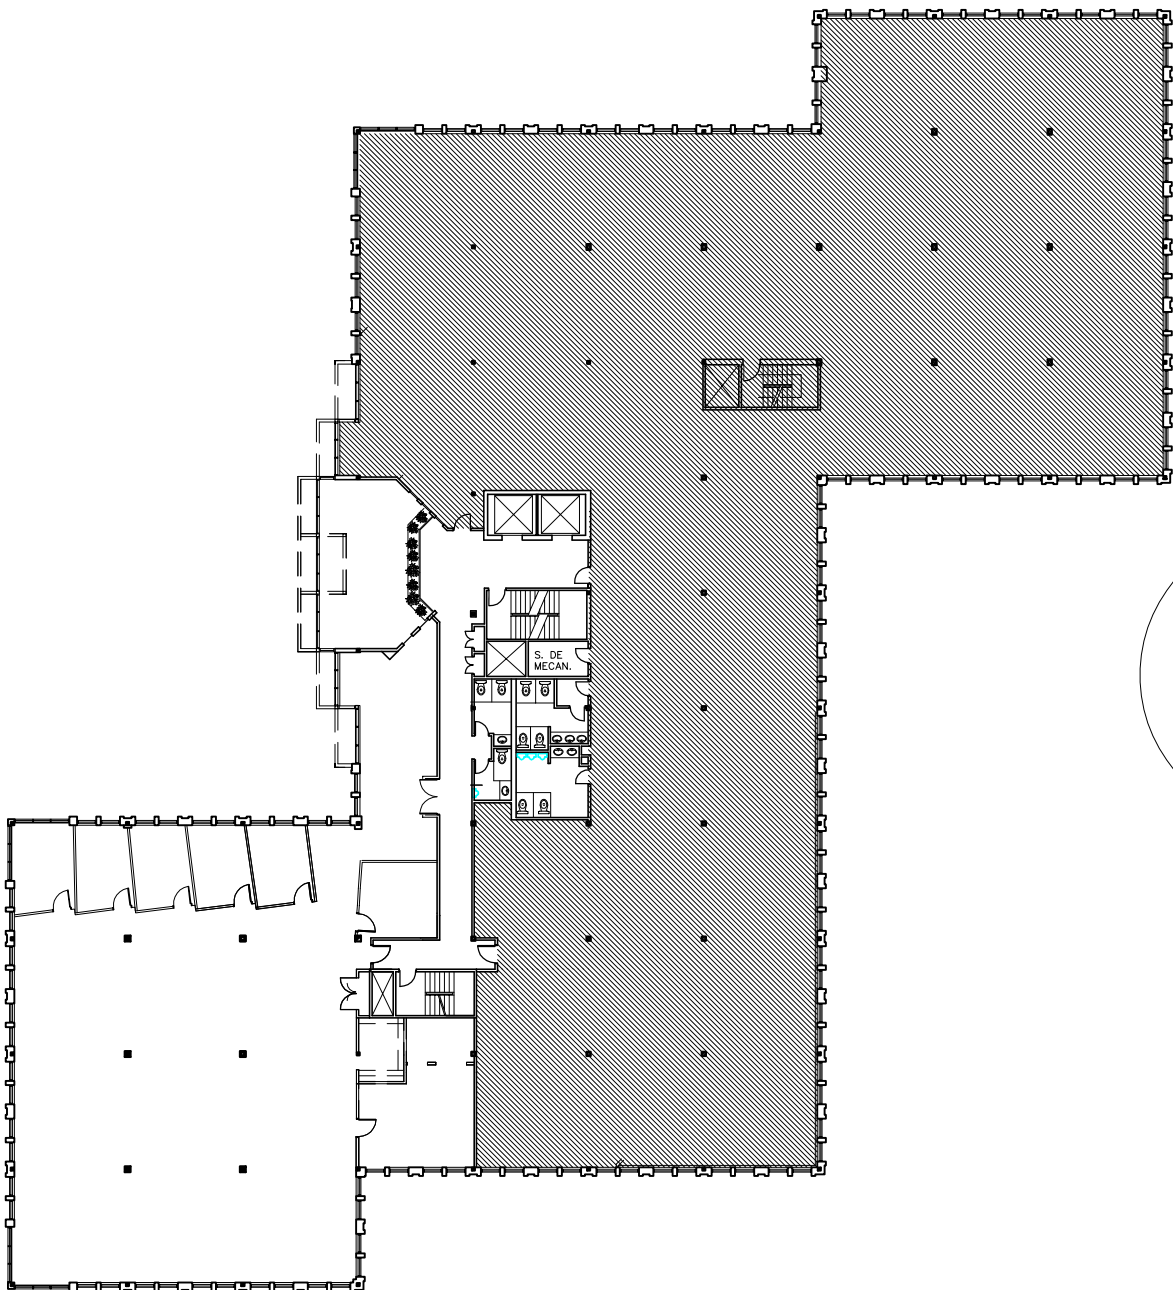

TEL QU'EXISTANT / AS BUILT PLAN

7 405 TRANS-CANADA

VILLE ST. LAURENT

REDBOURNE