


SUITE

± 7 200 pi. ca.

**1000**

± 7 200 sq. ft.

# Cours Mont-Royal

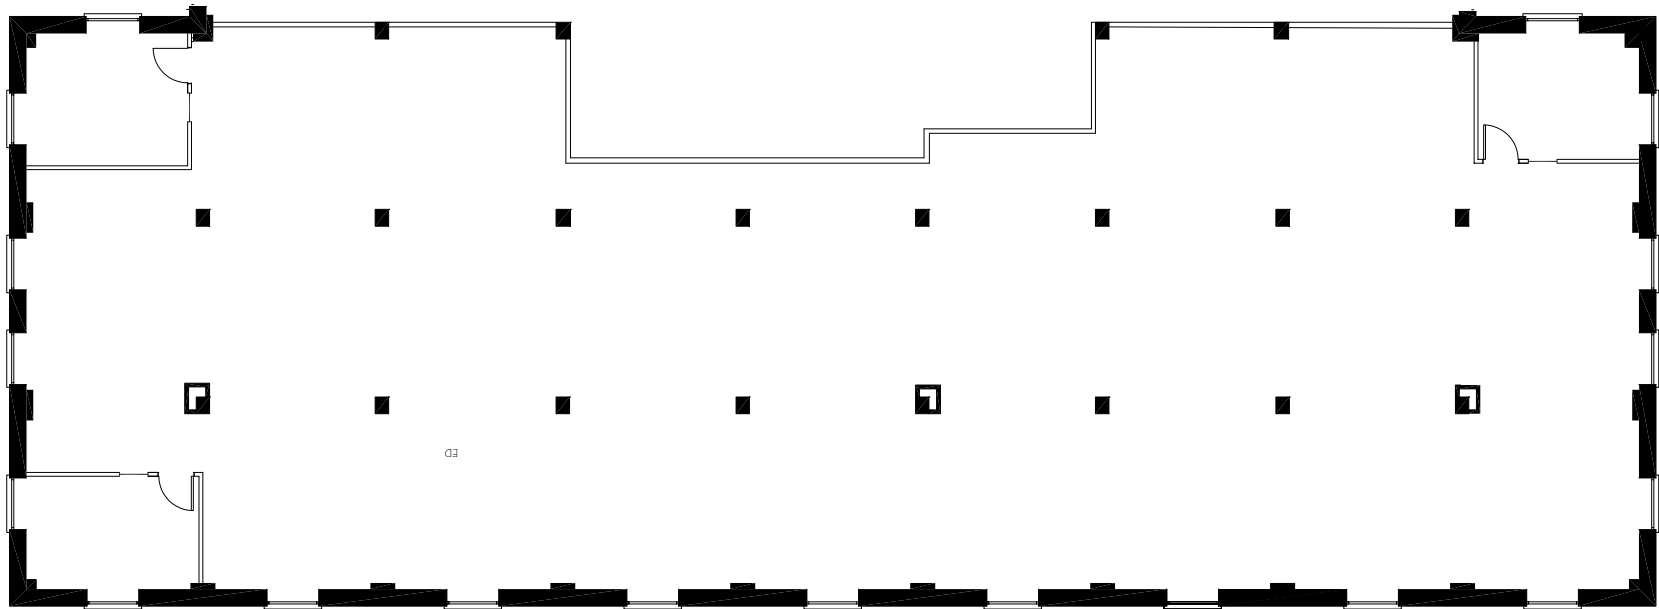

**REDBOURNE**

**AS BUILT PLAN - TEL QUE CONSTRUIT  
1550 METCALFE - COURS MONT-ROYAL**

**RUE METCALFE / METCALFE STREET**