


MANSFIELD

STE-CATHERINE

5 619 PI.CA. 3010 5 619 SQ.FT.

SUITE

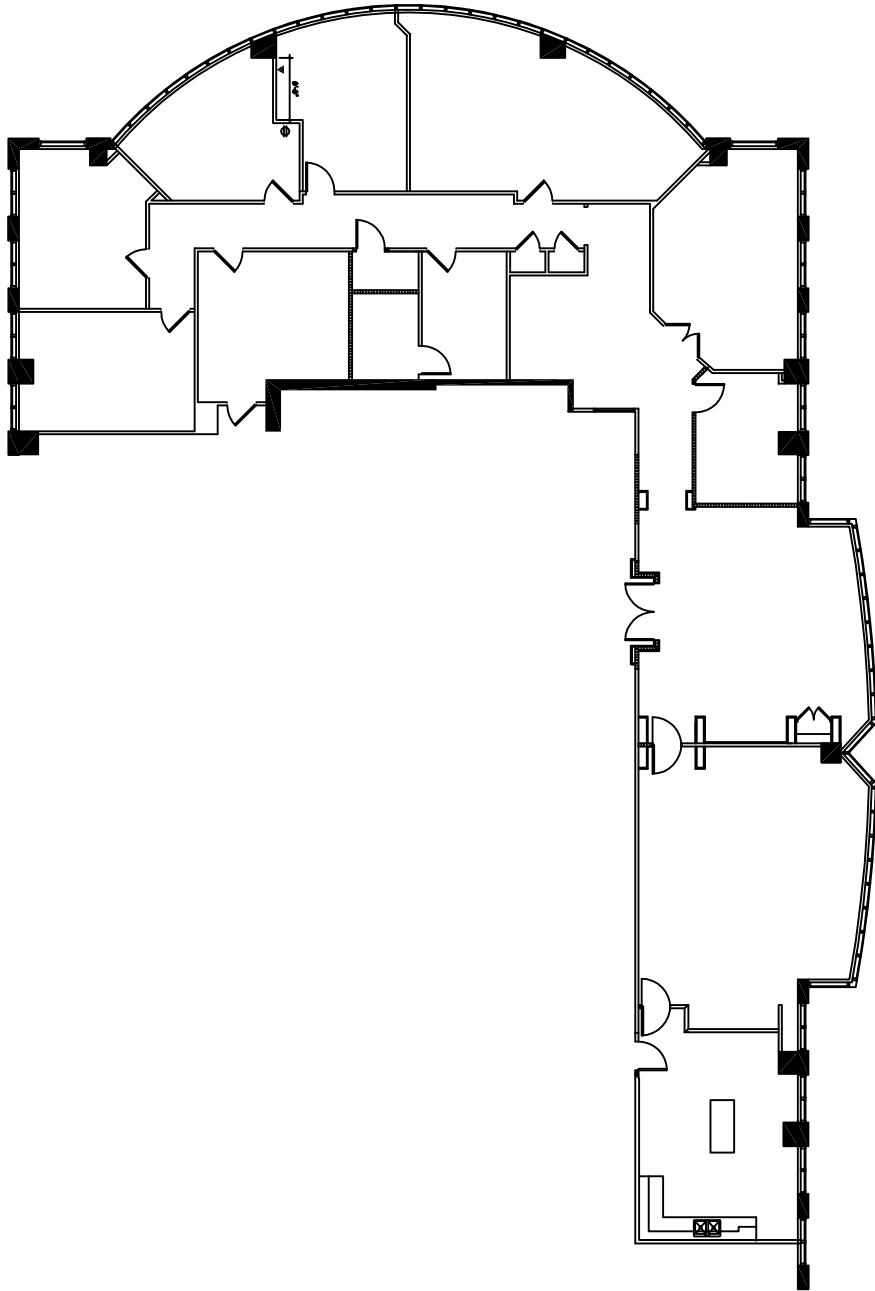

MCGILL COLLEGE

DE MAISONNEUVE

PLAN TEL QU'EXISTANT / AS BUILT PLAN

1 800 MCGILL COLLEGE
PLACE MONTREAL TRUST

REDBOURNE