

SUITE

± 2 668 pi. ca.

2420


± 2 668 sq. ft.

PLACE MONTREAL TRUST

MANSFIELD

STE-CATHERINE

De MAISONNEUVE

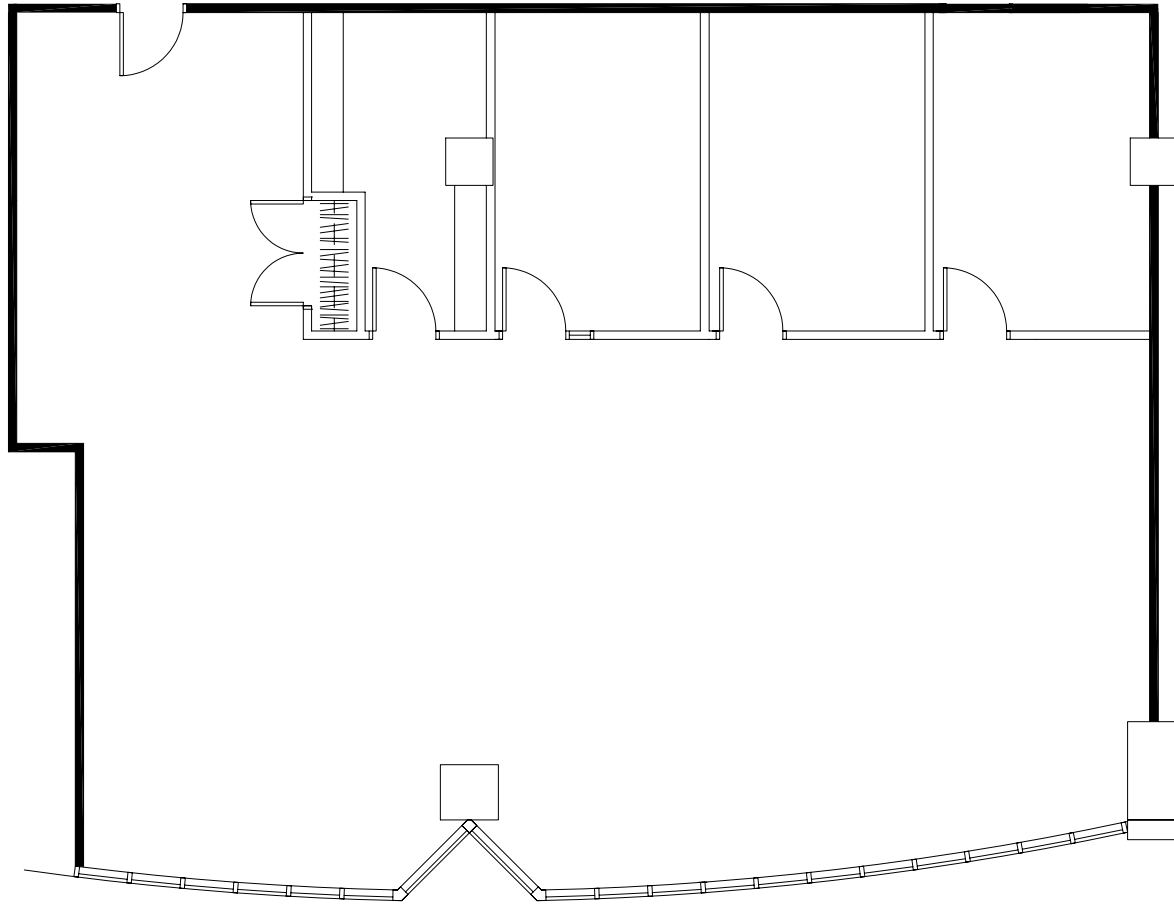

REDBOURNE

**AS BUILT PLAN - TEL QUE CONSTRUIT
1 8 0 0 MCGILL COLLEGE**

MCGILL COLLEGE