

SUITE

± 20 509 pi. ca.

600


± 20 509 sq. ft.

PLACE MONTREAL TRUST

MANSFIELD

STE-CATHERINE

De MAISONNEUVE

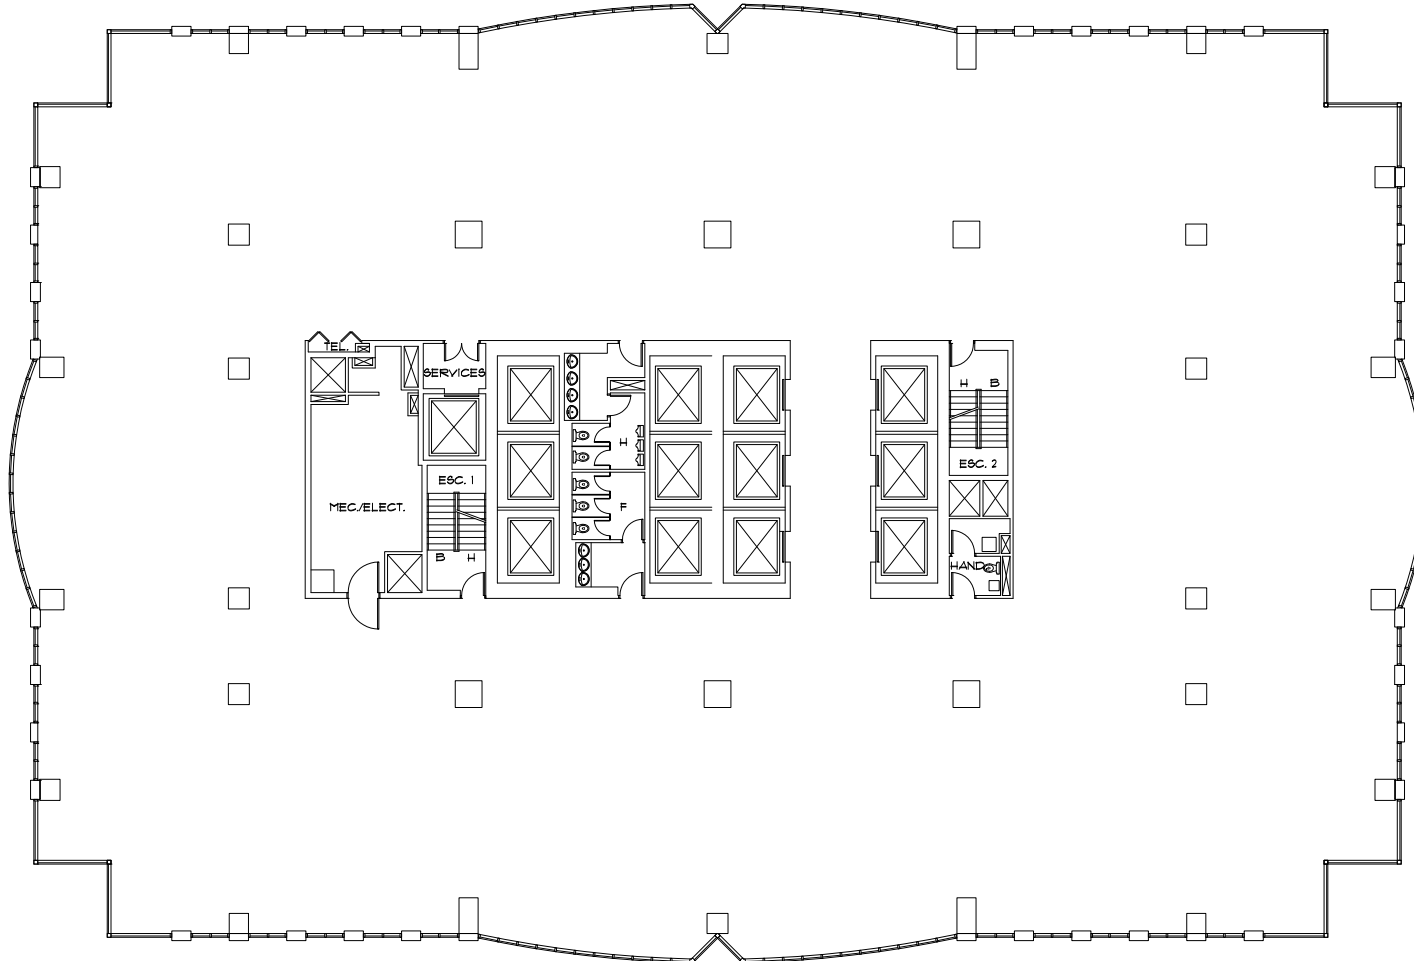

REDBOURNE

AS BUILT PLAN - TEL QUE CONSTRUIT
1 8 0 0 MCGILL COLLEGE

MCGILL COLLEGE