

\*  
MANSFIELD


5 559 P.I.C.A.

SUITE

3000

5 559 P.I.C.A.

STE-CATHERINE

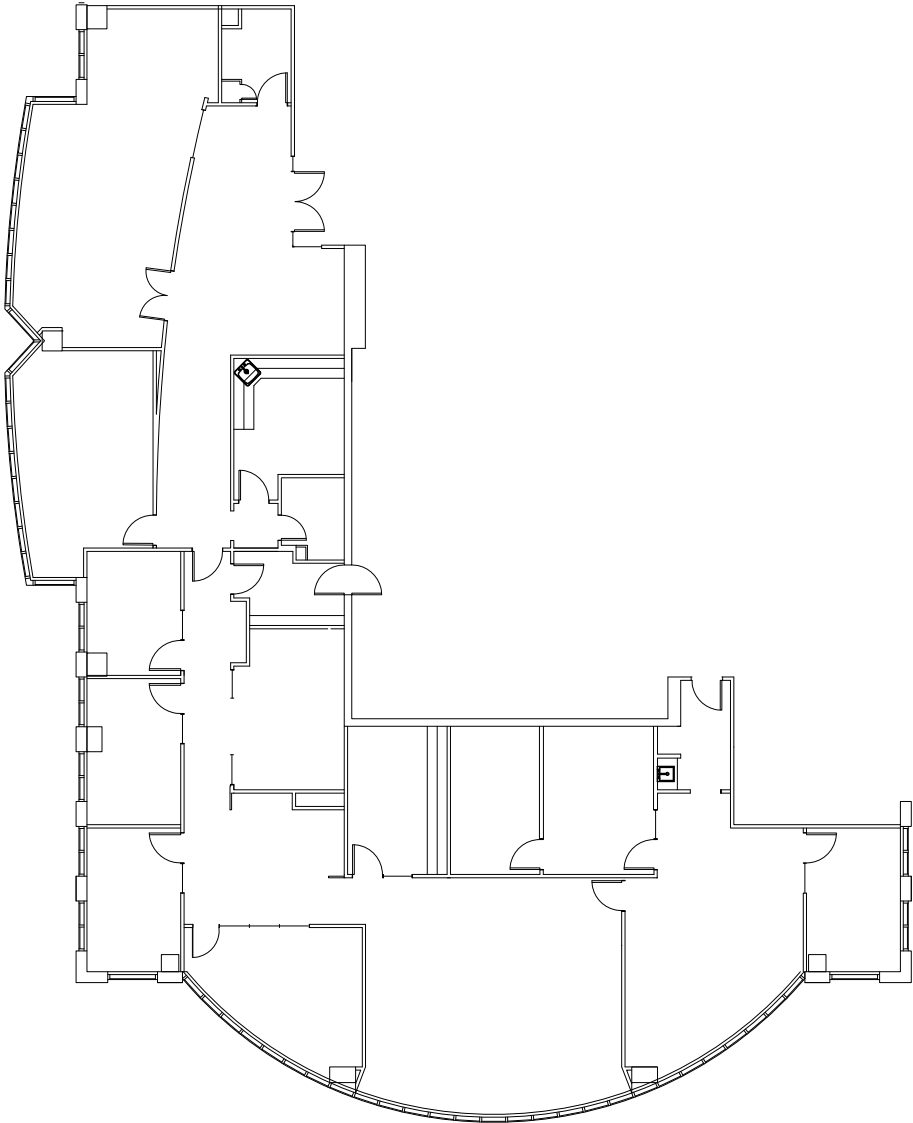

MC GILL COLLEGE

DE MAISONNEUVE

TEL QUE CONSTRUIT/AS BUILT PLAN

1 800 MCGILL COLLEGE  
PLACE MONTREAL TRUST

REDBOURNE