


1862 PL.CA

SUITE

1103

1862 SQ.FT.

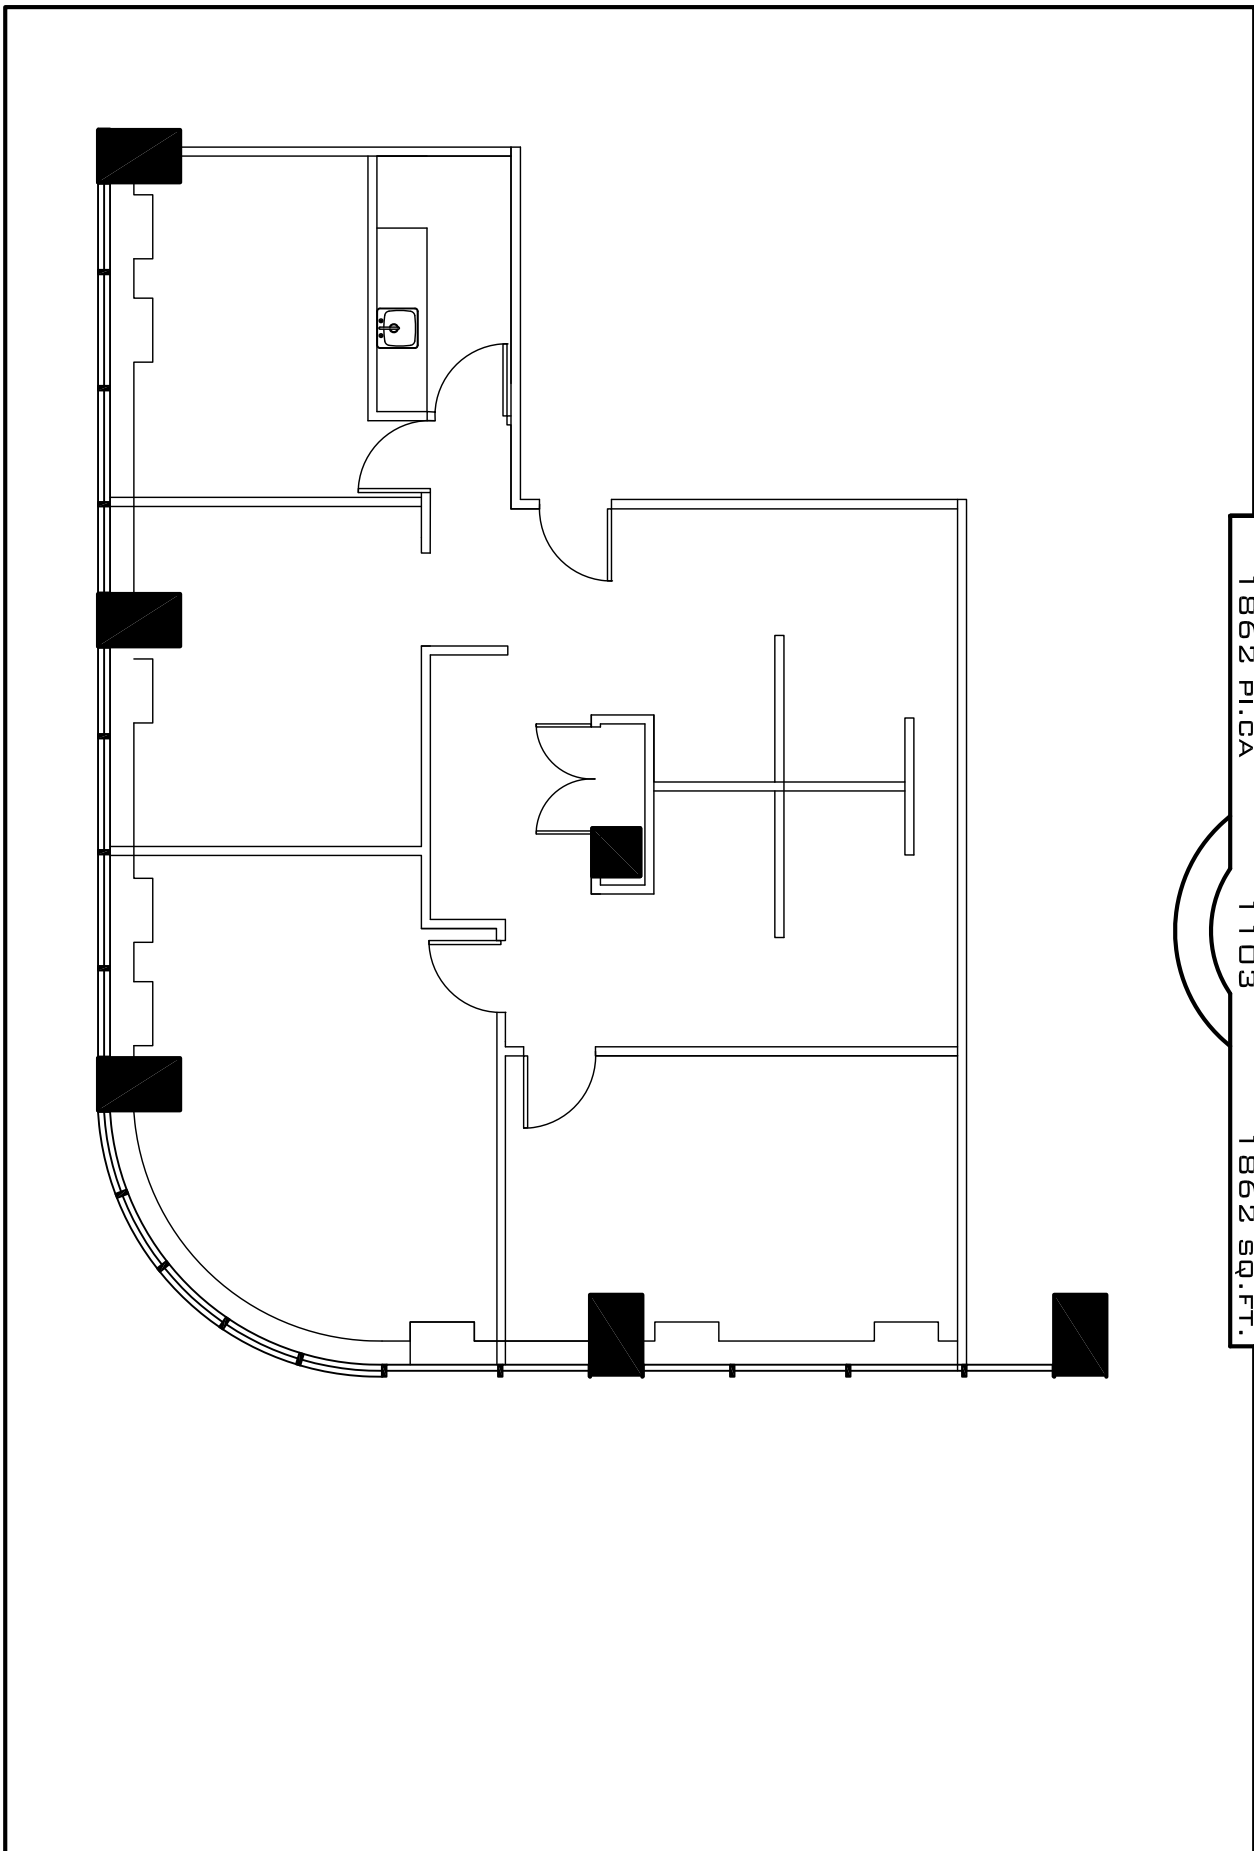

TEL Q'EXISTANT / AS BUILT

PLACE DU PARC

300, LÉO - PARISEAU

REDBOURNE