


SUITE

± 2 523 pi. ca.

120

± 2,523 sq. ft.

PLACE AGROPUR

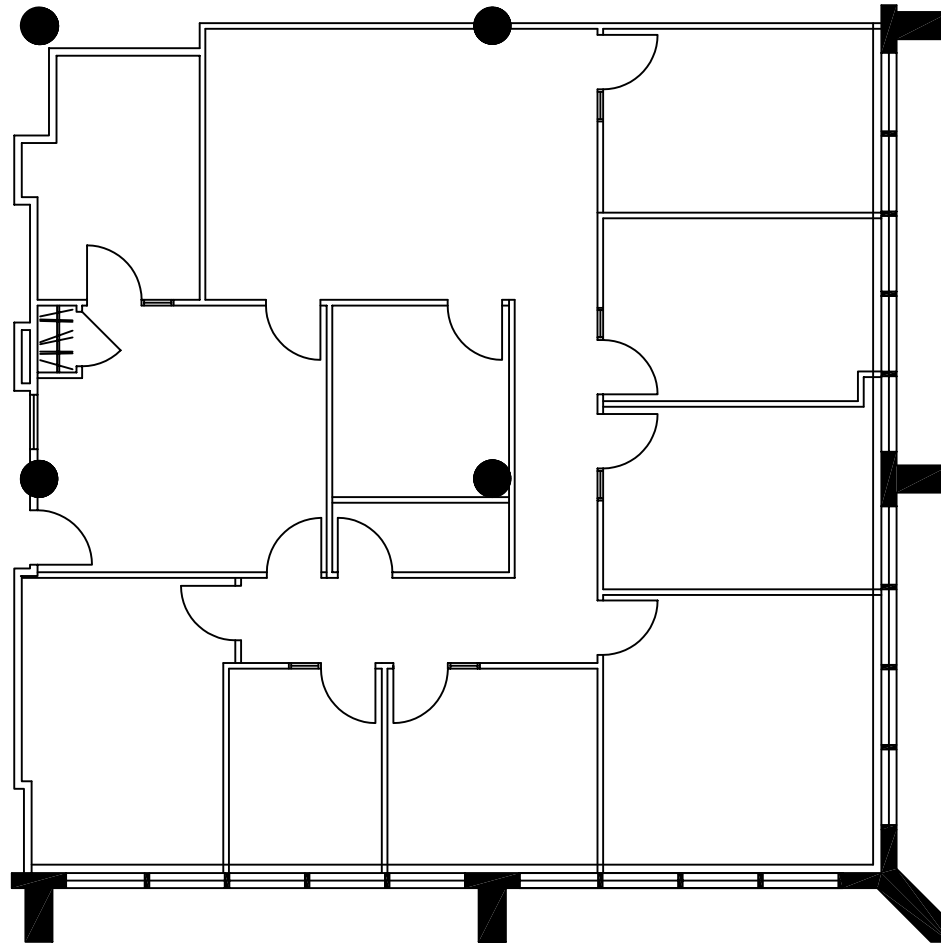

REDBOURNE

AS BUILT PLAN - TEL QUE CONSTRUIT
101, ROLAND-THERRIEN, VILLE DE LONGUEUIL