


1800 McGill College Avenue  
Montreal, Quebec H3A 3J8

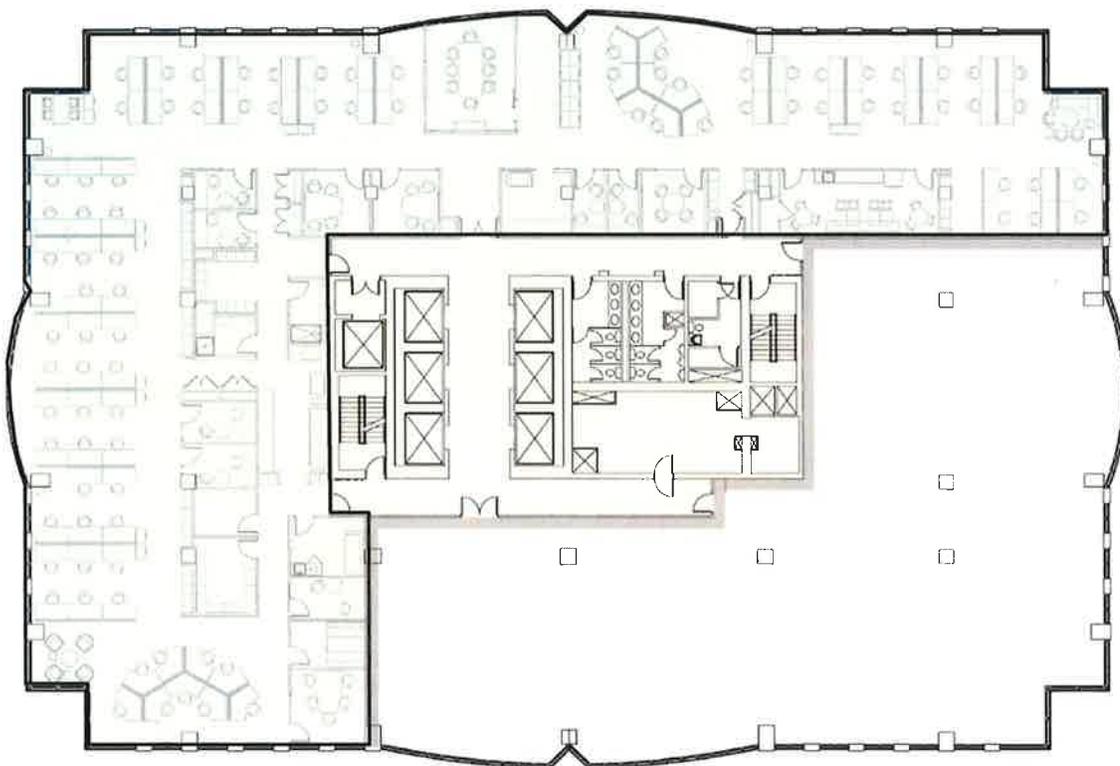

23<sup>rd</sup> floor

Sublease

Layout

- Kitchen
- Approximately 90 open workstations
- 8 focus rooms or offices
- 6 conference rooms
- Lounge
- Server room
- Lockers
- Print room
- 2 showers

12,053

Total Rentable Area (SF)