


SUITE

1 587 pi. ca.

830

1,587 sq. ft.

*
STE-CATHERINE
MANSFIELD

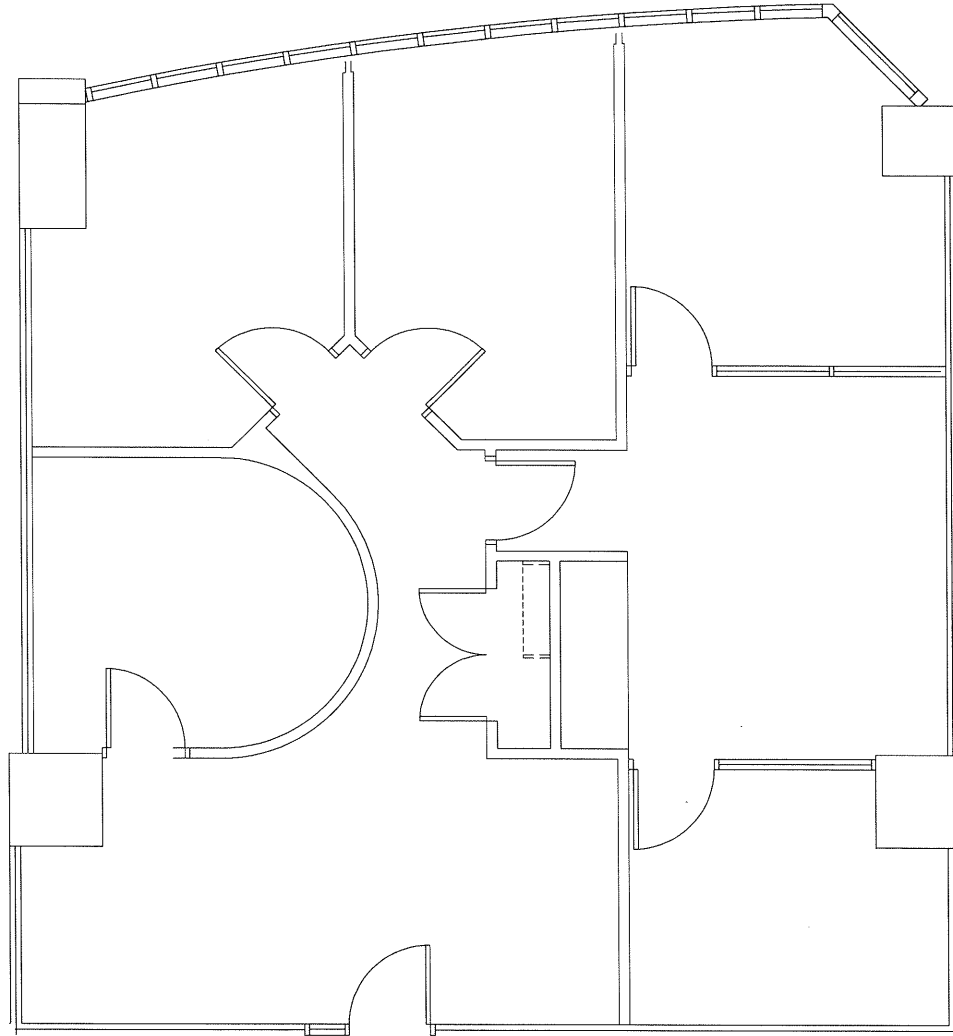

MCGILL COLLEGE

DE MAISONNEUVE

AS BUILT PLAN

1 800 MCGILL COLLEGE
PLACE MONTREAL TRUST

REDBOURNE